


LOCATION OF WATER WELL:	Fraction	Section Number	Township Number	Range Number
County: <u>Sedgwick</u>	SE ¼ SE ¼ SE ¼	8	T 25 S	R 1 W E/W

Distance and direction from nearest town or city street address of well if located within city?		
1	W. of Ridge Rd, 1/8 N. of 109th N., West side of road	Valley Center, Ks.
2	WATER WELL OWNER: Mark McGinn	
	RR#, St. Address, Box # : R.R. #5	Board of Agriculture, Division of Water Resources
	City, State, ZIP Code : Valley, Center, Ks.	Application Number:

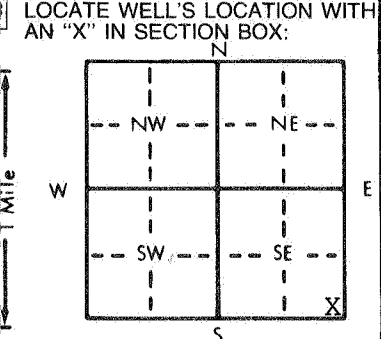

4 DEPTH OF COMPLETED WELL. 40. ft. ELEVATION:

Depth(s) Groundwater Encountered 1. 15. ft. 2. ft. 3. ft.

WELL'S STATIC WATER LEVEL . . . 15. ft. below land surface measured on mo/day/yr . . 9-28-84

Pump test data: Well water was ft. after hours pumping gpm

Est. Yield gpm: Well water was ft. after hours pumping gpm

Bore Hole Diameter . . 11. in. to ft., and in. to ft.

WELL WATER TO BE USED AS:

5 Public water supply	8 Air conditioning	11 Injection well		
1 Domestic	3 Feedlot	6 Oil field water supply	9 Dewatering	12 Other (Specify below)
2 Irrigation	4 Industrial	7 Lawn and garden only	10 Observation well	

Was a chemical/bacteriological sample submitted to Department? Yes.....No.....X.....; If yes, mo/day/yr sample was submitted

Water Well Disinfected?	Yes	X	No
-------------------------	-----	---	----

TYPE OF BLANK CASING USED:		CASING JOINTS:	
1 Steel	3 RMP (SR)	5 Wrought iron	8 Concrete tile
2 PVC	4 <u>ABS</u>	6 Asbestos-Cement	9 Other (specify below)
Blank casing diameter 5 . . . in. to 20 . . . ft., Dia	7 Fiberglass	Cer-Mac styrene SDR-26	Threaded
Casing height above land surface 12 . . . in., weight 1.59 . . . lbs./ft.			Welded
TYPE OF SCREEN OR PERFORATION MATERIAL:		Wall thickness or gauge No. 203 . . .	
1 Steel	3 Stainless steel	5 Fiberglass	7 PVC
2 Brass	4 Galvanized steel	6 Concrete tile	8 RMP (SR)
			9 <u>ABS</u>
SCREEN OR PERFORATION OPENINGS ARE:		10 Asbestos-cement	
1 Continuous slot	3 Mill slot	5 Gauzed wrapped	8 <u>Saw cut</u>
2 Louvered shutter	4 Key punched	6 Wire wrapped	11 Other (specify)
		7 Torch cut	12 None used (open hole)
SCREEN-PERFORATED INTERVALS:		11 None (open hole)	
	From 20 . . . ft. to 40 . . . ft., From	9 Drilled holes	
	From	10 Other (specify)	
GRAVEL PACK INTERVALS:			
	From 14 . . . ft. to 40 . . . ft., From		
	From		

9 GROUT MATERIAL: 1 Neat cement 2 Cement grout 3 Bentonite 4 Other

Grout Intervals: From 4 ft. to 14 ft., From ft. to ft., From ft. to ft.

What is the nearest source of possible contamination:

1 <u>Septic tank</u>	4 Lateral lines	7 Pit privy	10 Livestock pens	14 Abandoned water well
2 <u>Sewer lines</u>	5 Cess pool	8 Sewage lagoon	11 Fuel storage	15 Oil well/Gas well
3 Watertight sewer lines	6 Seepage pit	9 Feedyard	12 Fertilizer storage	16 Other (specify below)
			13 Insecticide storage	

Direction from well? East How many feet? 52

[illegible]

7] CONTRACTOR'S OR LANDOWNER'S CERTIFICATION: This water well was (1) constructed, (2) reconstructed, or (3) plugged under my jurisdiction and was completed on (mo/day/year) . . . 9-28-84 and this record is true to the best of my knowledge and belief. Kansas Water Well Contractor's License No. 236 This Water Well Record was completed on (mo/day/yr) 4-30-85 under the business name of Harp Well & Pump Service, Inc. by (signature) Mary Arnold

INSTRUCTIONS: Use typewriter or ball point pen, PLEASE PRESS FIRMLY and PRINT clearly. Please fill in blanks, underline or circle the correct answers. Send top three copies to Kansas Department of Health and Environment, Division of Environment, Environmental Geology Section, Topeka, KS 66620. Send one to WATER WELL OWNER and retain one for your records.