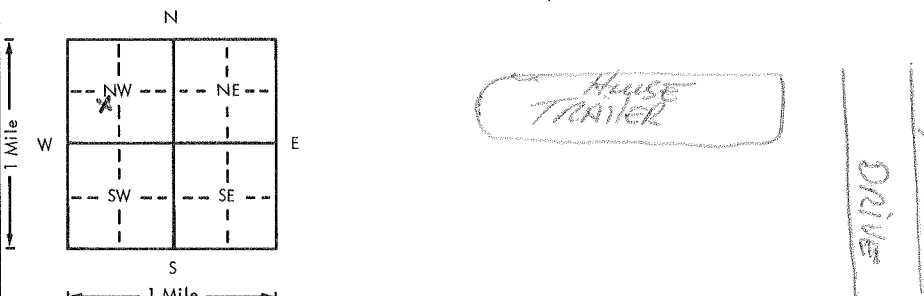


USE TYPEWRITER OR BALL
POINT PEN-PRESS FIRMLY,
PRINT CLEARLY.

WATER WELL RECORD
KSA 82a-1201-1215

Kansas Department of Health and
Environment-Division of Environment
(Water well Contractors)
Topeka, Kansas 66620

1. Location of well:	County SEOGWICK	Fraction NE 1/4 SW 1/4 NW 1/4	Section number 8	Township number T 25 S R 1W E/W	Range number
2. Distance and direction from nearest town or city: Street address of well location if in city:	1 mile S. of 2 1/2 miles W. of SEOGWICK		3. Owner of well: OWEN STANLEY R.R. or street: RT. 1 City, state, zip code: SEOGWICK, KS.		
4. Locate with "X" in section below:	Sketch map: 		6. Bore hole dia. 11 in. Completion date 10-12-77 Well depth 53 ft.		
5. Type and color of material	From		To		7. Cable tool ☒ Rotary ☐ Driven ☐ Dug ☐ Hollow rod ☐ Jetted ☐ Bored ☐ Reverse rotary
TOPSOIL	0		8		8. Use: ☒ Domestic ☐ Public supply ☐ Industry ☐ Irrigation ☐ Air conditioning ☐ Stock ☐ Lawn ☐ Oil field water ☐ Other
SAND - FINE	9		25		9. Casing: Material STEEL Height Above or below Threaded ☐ Welded ☒ Surface 12 in. RMP ☐ PVC ☐ Weight 1.5 lbs./ft. Dia. 5 in. to 53 ft. depth Wall Thickness: inches or Dia. ☐ in. to ☐ ft. depth gage No. 200
CLAY	28		36		10. Screen: Manufacturer's name JOL Type 100 Dia. 5" Slot/gauze .065 Length 10' Set between 43 ft. and 53 ft. ft. and ☐ ft.
SAND - FINE	37		45		Gravel pack? ☒ YES Size range of material 3/8" - 3/4"
GRAVEL - COURSE	46		53		11. Static water level: ☐ mo./day/yr. 15 ft. below land surface Date 10-12-77
					12. Pumping level below land surfaces: 15 ft. after 1 hrs. pumping 15 g.p.m. ft. after ☐ hrs. pumping ☐ g.p.m. Estimated maximum yield 50 g.p.m.
					13. Water sample submitted: ☐ Yes ☒ No Date ☐
					14. Well head completion: ☒ Pitless adapter ☐ _____ Inches above grade
					15. Well grouted? ☒ YES With: ☒ Neat cement ☐ Bentonite ☐ Concrete Depth: From 0 ft. to 10 ft.
					16. Nearest source of possible contamination: ft. 100 Direction N Type SEWAGE Well disinfected upon completion? ☒ Yes ☐ No
					17. Pump: ☐ Not installed Manufacturer's name DANFOS Model number DN7552 HP 3 Volts 220 Length of drop pipe 48 ft. capacity 15 g.p.m. Type: ☒ Submersible ☐ Turbine ☐ Jet ☐ Reciprocating ☐ Centrifugal ☐ Other
18. Elevation:	19. Remarks: CUSTOMER TO POUR CONCRETE SLAB - SIGNATURE ON SITE		20. Water well contractor's certification: This well was drilled under my jurisdiction and this report is true to the best of my knowledge and belief. 2151 Electric Co. 129 Business name License No. Address 512 W. 21ST Signed J. Harris Date 10-26-77 Authorized representative		

Forward the white, blue and pink copies to the Department of Health and Environment

Form WWC-5