Sent 11/6/75 ✓

USE TYPEWRITER OR BALL POINT PEN-PRESS FIRMLY, PRINT CLEARLY.

T R EW sec 1/4 1/4 1/4 No.

WATER WELL RECORD
KSA 82a-1201-1215

Kansas State Dept. Of Health
(Water Well Contractors)
Forbes-Bldg. 740
Topeka, Kansas 66620

SWNESW

1 Location of well:	County	Township name	Fraction	Section number	Town number	Range number
	Sedgwick	Valley	~~A 25 S~~	10	T 25 S	R-1-W

Distance and direction from nearest town or city: 2s ¾ E of Sedgwick

Street address of well location if in city:

3 Owner of well: Wilfred Berkamp Beergkamp

Address: Rt. 2 Sedgwick Ks

Locate with "X" in section below:

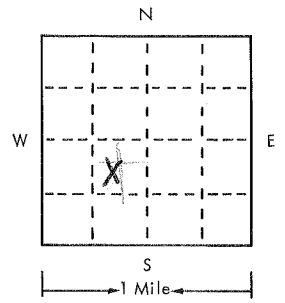

Sketch map:

CPC

2 Type and color of material	From	To
Top soil	0	20
gravel	20	65

(use a second sheet if needed)

4 Well depth: 65 ft. Date of completion 2-1-75
Well diameter 30 in.

5 ☐ Cable tool ☐ Rotary ☐ Driven ☐ Dug ☐ Hollow rod ☐ Jetted ☐ Bored ☒ Reverse rotary

6 Use: ☐ Domestic ☐ Public supply ☐ Industry ☒ Irrigation ☐ Air conditioning ☐ Commercial ☐ Test well ☐ _____

7 Casing: Material Cem (I) Height: above/~~below~~
Threaded ☐ Welded ☐ Surface 36 in.
Diam. 16 in. to 65 ft. depth Weight 33 lbs./ft.
Drive shoe? ☐ Yes ☒ No
___ in. to ___ ft. depth

8 Screen:
Manufacturer Hastings
Type Ab-Cem Dia. 16"
Slot/~~gauge~~ 1/4 Length 26
Set between 39 ft. and 65 ft.
Fittings:
Gravel pack ☒ Yes ☐ No Size range of material 3/8

9 Static water level:
20 ft. below land surface Date 2-1-75

10 Pumping level below land surfaces:
___ ft. after ___ hrs. pumping ___ g.p.m.
___ ft. after ___ hrs. pumping ___ g.p.m.
Estimated maximum yield ___ g.p.m.

11 Water sample submitted:
☐ Yes ☒ No Date ___

12 Well head completion:
☐ Pitless adapter 36 inches above grade

13 Well grouted? ☒ Yes ☐ No
☒ Neat cement ☐ Bentonite ☐ _____
Depth: From 0 ft. to 11 ft.

14 Nearest source of possible contamination:
ft. 100 Direction North Type Lagoon
Well disinfected upon completion? ☒ Yes ☐ No

15 Pump: ☐ Not installed
Manufacturer's name Peerless
Model number 6-1462A HP 15 Volts 440
Length of drop pipe 40 ft. capacity 600 g.m.p.
Type:
☐ Submersible ☒ Turbine
☐ Jet ☐ Reciprocating
☐ Certrifugal ☐ Other

16 Remarks: elevation

Topography:
☒ Hill
☐ Slope
☐ Upland
☐ Valley

17 Water well contractor's certification:
This well was drilled under my jurisdiction and this report is true to the best of my knowledge and belief.
Wenungs Drilling 238
Business name License No.
Address Waize Ks
Signed DM Wenning Date 2-29-75
Authorized representative

Forward the white, blue and pink copies to the Kansas State Dept. Of Health.

Form WWC-5

116 33

138