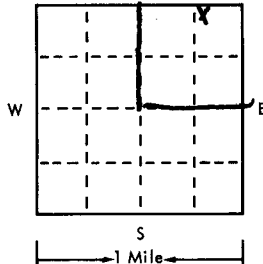
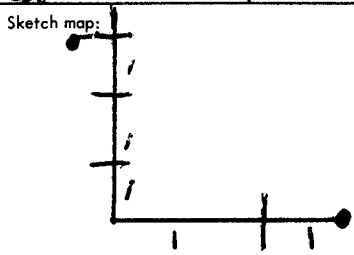


USE TYPEWRITER OR BALL
POINT PEN-PRESS FIRMLY,
PRINT CLEARLY.

WATER WELL RECORD
KSA 82a-1201-1215

25 1 W 15 NW 1/4 NE 1/4
T R EW sec 1/4 1/4 1/4 No.

Kansas State Dept. Of Health
(Water Well Contractors)
Forbes-Bldg. 740
Topeka, Kansas 66620

1 Location of well:	County	Township name	Fraction	Section number	Town number	Range number
	Sedgewick	Valley	NE/NE/NE	15	25 S	1 W
Distance and direction from nearest town or city:	center 3 1/2 2 west valley Rd			3 Owner of well:	Bill Wilbur	
Street address of well location if in city:				Address:	RFD Valley Center, Kansas 67147	
Locate with "X" in section below:	Sketch map:			4 Well depth: 56 ft. Date of completion 6/24/77 Well diameter 26 in.		
				5 ☐ Cable tool ☐ Rotary ☐ Driven ☐ Dug ☐ Hollow rod ☐ Jetted ☐ Bored ☒ Reverse rotary		
				6 Use: ☐ Domestic ☐ Public supply ☐ Industry ☒ Irrigation ☐ Air conditioning ☐ Commercial ☐ Test well ☐		
7 Casing: Material Transite above/below Threaded ☐ Welded ☐ Surface 18 in. Diam. 16 in. to 30 ft. depth Drive shoe? ☐ Yes ☒ No 16 in. to 30 ft. depth				8 Screen: Manufacturer Johnson Type sawed Dia. 16 Slot/gauze 3/16 Length 26 Set between 30 ft. and 56 ft. Fittings: Gravel pack ☒ Yes ☐ No Size range of material 6-12		
9 Static water level: 17 ft. below land surface Date 6/24/77				10 Pumping level below land surfaces: 31 ft. after 1 hrs. pumping 800 g.p.m. 43 ft. after 2 hrs. pumping 1200 g.p.m. Estimated maximum yield 1200 g.p.m.		
11 Water sample submitted: ☐ Yes ☒ No Date				12 Well head completion: ☐ Pitless adapter 18 inches above grade		
13 Well grouted? ☒ Yes ☐ No ☐ Neat cement ☐ Bentonite ☐ concrete Depth: From 0 ft. to 10 ft.				14 Nearest source of possible contamination: ft. 600 Direction N. BARN YARD Well disinfected upon completion? ☐ Yes ☒ No		
15 Pump: Manufacturer's name Western Land Roller Model number 12125H 25 Volts 440 Length of drop pipe 50 ft. capacity 110 g.p.m. Type: ☐ Submersible ☒ Turbine ☐ Jet ☐ Reciprocating ☐ Centrifugal ☐ Other				16 Remarks: elevation		
Topography: ☐ Hill ☐ Slope ☐ Upland ☒ Valley				17 Water well contractor's certification: This well was drilled under my jurisdiction and this report is true to the best of my knowledge and belief. Darling Drilling Co. 189 Business name License No. Address 211 W. 4th Hutchinson, Ks. Signed [Signature] Date 6-18-79 Authorized representative		

Forward the white, blue and pink copies to the Kansas State Dept. Of Health.

Form WWC-5