

1 LOCATION OF WATER WELL: County: SEDGWICK		Fraction NW₁/₄ SE ₁/₄ NE ₁/₄	Section Number 25	Township Number T 25 S	Range Number R 1 W (E-W)
--	--	--	-----------------------------	----------------------------------	------------------------------------


Distance and direction from nearest town or city street address of well if located within city?

#2 Tradewind Ct. Valley Center, Kansas

2] WATER WELL OWNER:	William Carlson	
RR#, St. Address, Box # :	#2 Tradwind Ct.	Board of Agriculture, Division of Water Resources
City, State, ZIP Code :	Valley Center, Kansas	Application Number:

3 LOCATE WELL'S LOCATION WITH AN "X" IN SECTION BOX: 4 DEPTH OF COMPLETED WELL..... 50 ft. ELEVATION: 17

Depth(s) Groundwater Encountered 1. 17 ft. 2. ft. 3. ft. 6-16-87
WELL'S STATIC WATER LEVEL 17 ft. below land surface measured on mo/day/yr

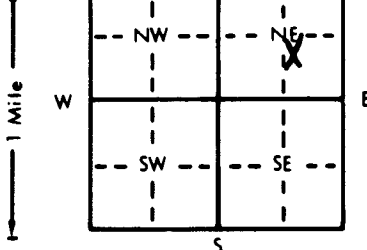

Pump test data: Well water was ft. after hours pumping gpm
 Est. Yield gpm: Well water was ft. after hours pumping gpm
 Bore Hole Diameter. 11 in. to ft. and in. to ft.
 WELL WATER TO BE USED AS: 5 Public water supply 8 Air conditioning 11 Injection well
 1 Domestic 3 Feedlot 6 Oil field water supply 9 Dewatering 12 Other (Specify below)
 2 Irrigation 4 Industrial 7 Lawn and garden only 10 Observation well
 Was a chemical/bacteriological sample submitted to Department? Yes.....No XX; If yes, mo/day/yr sample was sub-
 mitted Water Well Disinfected? Yes XX No

5	TYPE OF BLANK CASING USED:	5 Wrought iron	8 Concrete tile	CASING JOINTS: Glued . XX . Clamped
---	----------------------------	----------------	-----------------	--

1 Steel	<u>3 RMP (SR)</u>	6 Asbestos-Cement	9 Other (specify below)	Welded
2 PVC	4 ABS	7 Fiberglass	Con-Mag; styrene; SBR-26	Threaded

Blank casing diameter 5 in. to 30 ft., Dia Cel-Mac styrene SBR-20 in. to ft., Dia in. to ft.
Casing height above land surface 12 in. weight 1.59 lbs./ft. Wall thickness or gauge No.203

TYPE OF SCREEN OR PERFORATION MATERIAL:			7 PVC	10 Asbestos-cement
1 Steel	3 Stainless steel	5 Fiberglass	8 RMP (SR)	11 Other (specify)
2 Brass	4 Galvanized steel	6 Concrete tile	<u>9 ABS</u>	12 None used (open hole)

SCREEN OR PERFORATION OPENINGS ARE: 5 Gauzed wrapped 8 Saw cut 11 None (open hole)

1 Continuous slot	3 Mill slot	6 Wire wrapped	9 <u>Drilled holes</u>
2 Louvered shutter	4 Key punched	7 Torch cut	10 Other (specify)

SCREEN-PERFORATED INTERVALS: From 30 ft. to 50 ft., From ft. to ft.
From ft. to ft., From ft. to ft.

GRAVEL PACK INTERVALS: From 24 ft. to 50 ft., From ft. to ft.
From ft. to ft., From ft. to ft.

6 GROUT MATERIAL: 1 Neat cement 2 Cement grout 3 Bentonite 4 Other
Grout Intervals: From 4 ft. to 24 ft. From ft. to ft. From ft. to ft.

What is the nearest source of possible contamination: 10 Livestock pens 14 Abandoned water well

1 Septic tank	4 Lateral lines	7 Pit privy	10 Fuel storage	15 Oil well/Gas well
2 Sewer lines	5 Cess pool	8 Sewage lagoon	12 Fertilizer storage	16 Other (specify below)
3 Watertight sewer lines	6 Seepage pit	9 Feedyard	13 Insecticide storage	

Direction from well?	West	How many feet?	67
----------------------	------	----------------	----

FROM	TO	LITHOLOGIC LOG	FROM	TO	LITHOLOGIC LOG
------	----	----------------	------	----	----------------

0	3	Topsoil			
---	---	---------	--	--	--

3	21	Clay			
---	----	------	--	--	--

21	29	Fine Sand			
----	----	-----------	--	--	--

29	50	Medium Sand			
----	----	-------------	--	--	--

[illegible][illegible][illegible][illegible][illegible][illegible][illegible][illegible]

--	--	--	--	--	--

[illegible][illegible]

7. CONTRACTOR'S OR LANDOWNER'S CERTIFICATION: This water well was (1) constructed (2) reconstructed or (3) plugged under my jurisdiction and was

completed on (mo/day/year) 6-16-87 and this record is true to the best of my knowledge and belief. Kansas

Water Well Contractor's License No. 236 This Water Well Record was completed on (mo/day/yr) 8-28-87

under the business name of Harp Well & Pump Service, Inc. by (signature) Mary Arnold

INSTRUCTIONS: Use typewriter or ball point pen. PLEASE PRESS FIRMLY and PRINT clearly. Please fill in blanks, underline or circle the correct answers. Send top three copies to Kansas

Department of Health and Environment, Bureau of Water Protection, Topeka, Kansas 66620-7320, Telephone: 913-862-9360. Send one to WATER WELL OWNER and retain one for your

records.