

1 LOCATION OF WATER WELL:		Fraction	Section Number	Township Number	Range Number
County: Sedgwick		NE ¼ NE ¼ SW ¼	27	T 25 S	R 1 W E(W)


Distance and direction from nearest town or city street address of well if located within city?

85th St. N. and Ridge Rd., Lot 27, Wichita, KS.

2	WATER WELL OWNER: Geo. Clark	
	RR#, St. Address, Box # : 2551 Greenleaf	Board of Agriculture, Division of Water Resources
	City, State, ZIP Code : Wichita, KS.	Application Number:

3	LOCATE WELL'S LOCATION WITH AN "X" IN SECTION BOX:	4	DEPTH OF COMPLETED WELL.....	35	ft.	ELEVATION:
				15		

WELL'S STATIC WATER LEVEL 15 ft. below land surface measured on mo/day/yr 3-13-87

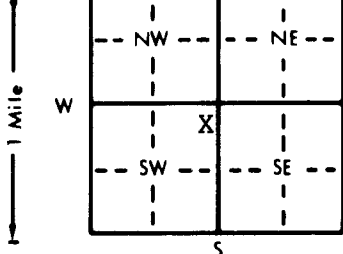

Pump test data: Well water was ft. after hours pumping gpm
Est. Yield gpm: Well water was ft. after hours pumping gpm
Bore Hole Diameter.....11.....in. toft., and.....in. toft.
WELL WATER TO BE USED AS:
 1 Domestic 3 Feedlot 6 Oil field water supply 8 Air conditioning 11 Injection well
 2 Irrigation 4 Industrial 7 Lawn and garden only 9 Dewatering 12 Other (Specify below)
Was a chemical/bacteriological sample submitted to Department? Yes.....No...**X**.....; If yes, mo/day/yr sample was sub-
mitted Water Well Disinfected? Yes **X** No

5 TYPE OF BLANK CASING USED:		5 Wrought iron	8 Concrete tile	CASING JOINTS: Glued . X . . . Clamped	
1 Steel	3 RMP (SR)	6 Asbestos-Cement	9 Other (specify below)	Welded	
2 PVC	<u>4 ABS</u>	7 Fiberglass	Cer-Mac Styrene - SDR-26	Threaded	
Blank casing diameter 5 in. to 20 ft., Dia		 in. to ft., Dia		 in. to ft.	
Casing height above land surface 12 in.		weight 1.59 lbs./ft.		Wall thickness or gauge No. 203	

TYPE OF SCREEN OR PERFORATION MATERIAL:			7 PVC	10 Asbestos-cement
1 Steel	3 Stainless steel	5 Fiberglass	<u>8 RMP (SR)</u>	11 Other (specify)
2 Brass	4 Galvanized steel	6 Concrete tile	9 ABS	12 None used (open hole)

SCREEN OR PERFORATION OPENINGS ARE:		5 Gauzed wrapped	<u>8 Saw cut</u>	11 None (open hole)
1 Continuous slot	3 Mill slot	6 Wire wrapped	9 Drilled holes	
2 Louvered shutter	4 Key punched	7 Torch cut	10 Other (specify)	

SCREEN-PERFORATED INTERVALS:	From 20 ft. to 35 ft.,	From ft. to ft.
	From ft. to ft.,	From ft. to ft.
GRAVEL PACK INTERVALS:	From 14 ft. to 35 ft.,	From ft. to ft.
	From ft. to ft.,	From ft. to ft.

6	GROUT MATERIAL:		1 Neat cement	2 Cement grout	3 Bentonite	4 Other
	Grout Intervals:	From	4	ft. to	14	ft.

What is the nearest source of possible contamination:			10 Livestock pens	14 Abandoned water well
1 Septic tank	4 Lateral lines	7 Pit privy	11 Fuel storage	15 Oil well/Gas well
2 Sewer lines	5 Cess pool	8 Sewage lagoon	12 Fertilizer storage	16 Other (specify below)
3 Watertight sewer lines	6 Seepage pit	9 Feedyard	13 Insecticide storage	NONE APPARENT

Direction from well? _____ How many feet? _____

[illegible]


water Well Contractor's License No. 236 This Water Well Record was completed on (mo./day/yr) 2/1/81
under the business name of Harp Well & Pump Service, Inc. by (signature) Mary Arnold
INSTRUCTIONS: Use typewriter or ball point pen. PLEASE PRESS FIRMLY and PRINT clearly. Please fill in blanks, underline or circle the correct answers. Send top three copies to Kansas
Department of Health and Environment, Bureau of Water Protection, Topeka, Kansas 66620-7320, Telephone: 913-862-9360. Send one to WATER WELL OWNER and retain one for your
records.