USE TYPEWRITER OR BALL POINT PEN-PRESS FIRMLY, PRINT CLEARLY.

WATER WELL RECORD
KSA 82a-1201-1215

Kansas Department of Health and Environment-Division of Environment
(Water well Contractors)
Topeka, Kansas 66620

1. Location of well:	County	Fraction	Section number	Township number	Range number
	Sedgwick	1/4 Ne 1/4 SE 1/4	35	T 25 S	R 1W E/W

2. Distance and direction from nearest town or city:
Street address of well location if in city: 4021 Rio Grande
Valley Center, Kansas

3. Owner of well: Walt Stauffer Construction
R.R. or street: 3535 West 13th Street
City, state, zip code: Wichita, Kansas

4. Locate with "X" in section below:

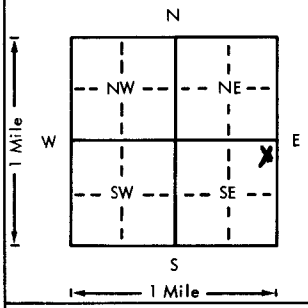

Sketch map:

6. Bore hole dia. 11 in. Completion date
Well depth 35 ft. 7-27-77

7. __ Cable tool X Rotary __ Driven __ Dug
__ Hollow rod __ Jetted __ Bored __ Reverse rotary

8. Use: X Domestic __ Public supply __ Industry
__ Irrigation __ Air conditioning __ Stock
__ Lawn __ Oil field water __ Other

9. Casing: Material Styrene Height: Above or below //
Threaded __ Welded gl Surface 12 in.
RMP X PVC __ Weight __ lbs./ft.
Dia 5 in. to 35 ft. depth Wall Thickness: inches or
Dia. __ in. to __ ft. depth gage No. .200

5. Type and color of material	From	To
Topsoil	0	3
Clay	3	10
Fine Sand	10	20
Medium Sand	20	35

(Use a second sheet if needed)

10. Screen: Manufacturer's name Sunflower Plastic
Type styrene Dia. 5"
Slot/gauge .06 Length 10'
Set between 25 ft. and 35 ft.
__ ft. and __ ft.
Gravel pack? yes Size range of material 1/4-1/8"

11. Static water level: mo./doy/yr.
15 ft. below land surface Date 7-27-77

12. Pumping level below land surfaces:
__ ft. after __ hrs. pumping __ g.p.m.
__ ft. after __ hrs. pumping __ g.p.m.
Estimated maximum yield __ g.p.m.

13. Water sample submitted: mo./doy/yr.
__ Yes __ No Date

14. Well head completion:
X Pitless adapter 12 Inches above grade

15. Well grouted? yes 1-2 fine sand mix
With: __ Neat cement __ Bentonite X Concrete
Depth: From 40' ft. to 14 ft.

16. Nearest source of possible contamination:
ft. __ Direction __ Type NONE
Well disinfected upon completion? X Yes __ No

17. Pump: __ Not installed
Manufacturer's name Sta-Rite
Model number 20P4D02 HP 3/4 Volts 230
Length of drop pipe 25 ft. capacity 30 g.p.m.
Type:
X Submersible __ Turbine
__ Jet __ Reciprocating
__ Centrifugal __ Other

18. Elevation:
Topography:
__ Hill
__ Slope
__ Upland
__ Valley

19. Remarks:
Flat Ground
Septic System not installed when the well was drilled.
No apparent source for contamination.

20. Water well contractor's certification:
This well was drilled under my jurisdiction and this report is true to the best of my knowledge and belief.
Harp Well & Pump Service, Inc. 236
Business name License No.
Address Wichita, Kansas 67209
Signed M. Arnold Date 8-1-77
Authorized representative

25 S 1 W 35 NE 1/4 1/4 1/4

Forward the white, blue and pink copies to the Department of Health and Environment

Form WWC-5

MI-1023