

1 LOCATION OF WATER WELL:	Fraction	Section Number	Township Number	Range Number
County: <u>Remo</u>	<u>NW 1/4 NE 1/4 NE 1/4</u>	<u>23</u>	T <u>25</u> S	R <u>10</u> E <u>W</u>

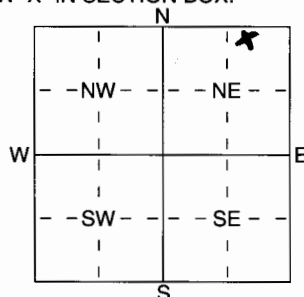
Distance and direction from nearest town or city street address of well if located within city?

From Landon, KS: 3 miles West + 1 mile North.2 WATER WELL OWNER: Larry PreitsserRR#, St. Address, Box # : 105 South east 130th Ave
City, State, ZIP Code : Lunningham, KS 67035

Board of Agriculture, Division of Water Resources

Application Number: 45,9093 LOCATE WELL'S LOCATION WITH 4 DEPTH OF COMPLETED WELL 90 ft. ELEVATION:

AN "X" IN SECTION BOX:

Depth(s) Groundwater Encountered 1 12 ft. 2 ft. 3 ft.
WELL'S STATIC WATER LEVEL 12 ft. below land surface measured on mo/day/yr 4-13-06

Pump test data: Well water was ft. after hours pumping gpm

Est. Yield 700 gpm: Well water was ft. after hours pumping gpm

WELL WATER TO BE USED AS: 5 Public water supply 8 Air conditioning 11 Injection well

1 Domestic 3 Feedlot 6 Oil field water supply 9 Dewatering 12 Other (Specify below)

2 Irrigation 4 Industrial 7 Domestic (lawn & garden) 10 Monitoring wellWas a chemical/bacteriological sample submitted to Department? Yes No X; If yes, mo/day/yr sample was submitted
Water Well Disinfected? Yes X No

5 TYPE OF BLANK CASING USED:

1 Steel 3 RMP (SR)
2 PVC 4 ABS5 Wrought iron 6 Asbestos-Cement
7 Fiberglass

8 Concrete tile 9 Other (specify below)

CASING JOINTS: Glued X Clamped
Welded
ThreadedBlank casing diameter 16 in. to 50 ft. Dia in. to ft. Dia in. to ft.Casing height above land surface 12 in., weight 16 lbs./ft. Wall thickness or gauge No. 1/2"

TYPE OF SCREEN OR PERFORATION MATERIAL:

1 Steel 3 Stainless Steel
2 Brass 4 Galvanized Steel

5 Fiberglass 6 Concrete tile

2 PVC8 RMP (SR)
9 ABS

10 Asbestos-Cement

11 Other (Specify)
12 None used (open hole)

SCREEN OR PERFORATION OPENINGS ARE:

1 Continuous slot 3 Mill slot
2 Louvered shutter 4 Key punched5 Gauzed wrapped
6 Wire wrapped
7 Torch cut2 Saw cut 11 None (open hole)
9 Drilled holes
10 Other (specify) ft.SCREEN-PERFORATED INTERVALS: From 50 ft. to 90 ft. From ft. to ft.

From ft. to ft. From ft. to ft.

GRAVEL PACK INTERVALS: From 20 ft. to 90 ft. From ft. to ft.

From ft. to ft. From ft. to ft.

6 GROUT MATERIAL: 1 Neat cement 2 Cement grout 3 Bentonite 4 Other

Grout intervals: From 3 ft. to 28 ft. From ft. to ft. From ft. to ft.

What is the nearest source of possible contamination:

1 Septic tank 4 Lateral lines
2 Sewer lines 5 Cess pool
3 Watertight sewer lines 6 Seepage pit7 Pit privy 8 Sewage lagoon
9 Feedyard10 Livestock pens 14 Abandoned water well
11 Fuel storage 15 Oil well/Gas well
12 Fertilizer storage 16 Other (specify below)
13 Insecticide storage None

Direction from well?

How many feet? Open field.

FROM	TO	LITHOLOGIC LOG	FROM	TO	PLUGGING INTERVALS
<u>0</u>	<u>2</u>	<u>Sandy Soil</u>			
<u>2</u>	<u>15</u>	<u>Fine Sand</u>			
<u>15</u>	<u>39</u>	<u>Fine to coarse sand</u>			
		<u>to Medium Gravel (loose)</u>			
<u>39</u>	<u>45</u>	<u>Sandy tan clay</u>			
<u>45</u>	<u>58</u>	<u>Fine to coarse sand</u>			
		<u>to Medium Gravel (loose)</u>			
<u>58</u>	<u>65</u>	<u>Tan clay</u>			
<u>65</u>	<u>90</u>	<u>Fine to coarse sand</u>			
		<u>to Medium Gravel (loose)</u>			

7 CONTRACTOR'S OR LANDOWNER'S CERTIFICATION: This water well was 1 constructed, (2) reconstructed, or (3) plugged under my jurisdiction and wascompleted on (mo/day/year) 4-15-06 and this record is true to the best of my knowledge and belief. KansasWater Well Contractor's Licence No. 238 This Water Well Record was completed on (mo/day/yr) 4-18-06under the business name of Premier Pump & Well Service Inc. by (signature) W. M. Wieringa