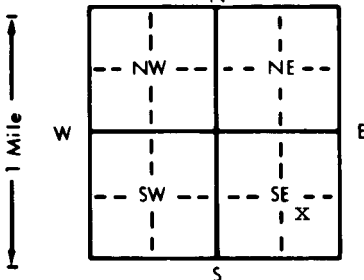


1 LOCATION OF WATER WELL:	Fraction	Section Number	Township Number	Range Number
County: Stafford	NW ¼ SE ¼ SE ¼	22	T 25 S	R 11 E/W

Distance and direction from nearest town or city street address of well if located within city?

Approximately 3/4 mile south and 1/4 mile west of Neola

2 WATER WELL OWNER:	Max Nichols	Board of Agriculture, Division of Water Resources
RR#, St. Address, Box # :	P.O. Box 515	Application Number: 42,022
City, State, ZIP Code :	Great Bend, KS 67530	

3 LOCATE WELL'S LOCATION WITH AN "X" IN SECTION BOX:	4 DEPTH OF COMPLETED WELL: 125 ft. ELEVATION: unknown
	Depth(s) Groundwater Encountered 1. ft. 2. ft. 3. ft.
	WELL'S STATIC WATER LEVEL . . . 20 . . . ft. below land surface measured on mo/day/yr 6-12-97
	Pump test data: Well water was not ch'd. ft. after hours pumping gpm
	Est. Yield unknown gpm: Well water was ft. after hours pumping gpm
	Bore Hole Diameter . . . 24 . . . in. to . . . 126 . . . ft. and in. to ft.
WELL WATER TO BE USED AS:	5 Public water supply 8 Air conditioning 11 Injection well
1 Domestic 3 Feedlot 6 Oil field water supply 9 Dewatering 12 Other (Specify below)	
2 Irrigation 4 Industrial 7 Lawn and garden only 10 Monitoring well	
Was a chemical/bacteriological sample submitted to Department? Yes No X If yes, mo/day/yr sample was submitted	Water Well Disinfected? Yes No X

5 TYPE OF BLANK CASING USED:	5 Wrought iron 8 Concrete tile CASING JOINTS: Glued . X . . . Clamped
1 Steel 3 RMP (SR) 6 Asbestos-Cement 9 Other (specify below) Welded	
2 PVC 4 ABS 7 Fiberglass Threaded	
Blank casing diameter . . . 16 . . . in. to . . . 39 . . . ft., Dia . . . 16 . . . in. to . . . 104 . . . ft., Dia in. to ft.	
Casing height above land surface . . . 12 . . . in., weight . . . 16.15 . . . lbs./ft. Wall thickness or gauge No. . . 500 . . .	
TYPE OF SCREEN OR PERFORATION MATERIAL:	7 PVC 10 Asbestos-cement
1 Steel 3 Stainless steel 5 Fiberglass 8 RMP (SR) 11 Other (specify)	
2 Brass 4 Galvanized steel 6 Concrete tile 9 ABS 12 None used (open hole)	
SCREEN OR PERFORATION OPENINGS ARE:	5 Gauzed wrapped 8 Saw cut 11 None (open hole)
1 Continuous slot 3 Mill slot 6 Wire wrapped 9 Drilled holes	
2 Louvered shutter 4 Key punched 7 Torch cut 10 Other (specify)	
SCREEN-PERFORATED INTERVALS:	From . . . 39 . . . ft. to . . . 99 . . . ft., From ft. to ft.
	From . . . 104 . . . ft. to . . . 124 . . . ft., From ft. to ft.
GRAVEL PACK INTERVALS:	From . . . 20 . . . ft. to . . . 101 . . . ft., From ft. to ft.
	From . . . 103 . . . ft. to . . . 125 . . . ft., From ft. to ft.

6 GROUT MATERIAL:	1 Neat cement 2 Cement grout 3 Bentonite 4 Other Bentonite Holeplug
Grout Intervals: From . . . 0 . . . ft. to . . . 20 . . . ft., From ft. to . . . 101 . . . ft. to . . . 103 . . . ft.	
What is the nearest source of possible contamination:	10 Livestock pens 14 Abandoned water well
1 Septic tank 4 Lateral lines 7 Pit privy 11 Fuel storage 15 Oil well/Gas well	
2 Sewer lines 5 Cess pool 8 Sewage lagoon 12 Fertilizer storage 16 Other (specify below)	
3 Watertight sewer lines 6 Seepage pit 9 Feedyard 13 Insecticide storage None known	
Direction from well?	How many feet?

FROM	TO	LITHOLOGIC LOG	FROM	TO	PLUGGING INTERVALS
0	3	Topsoil			
3	7	Clay, brown			
7	10	Sand, fine			
10	26	Clay, tan			
26	47	Sand and gravel, fine, medium, some coarse			
47	49	Clay, brown			
49	67	Sand and gravel, fine, medium, coarse			
67	72	Clay, tan and gray			
72	74	Clay with sand and gravel, hard			
74	100	Sand and gravel, fine, medium			
100	104	Clay, gray			
104	126	Sand and gravel, fine, medium, some coarse			

7 CONTRACTOR'S OR LANDOWNER'S CERTIFICATION: This water well was (1) constructed, (2) reconstructed, or (3) plugged under my jurisdiction and was completed on (mo/day/year) 6-12-97 and this record is true to the best of my knowledge and belief. Kansas Water Well Contractor's License No. 185 This Water Well Record was completed on (mo/day/yr) 6-26-97 under the business name of Clarke Well & Equipment, Inc. by (signature) <i>Clarke Well & Equipment, Inc.</i>
--