

1	LOCATION OF WATER WELL:	Fraction	Section Number	Township Number	Range Number
County:	XXXXXX Stafford	NW ¼ SW ¼ SE ¼	18	T 25 S	R 11 E/W

Distance and direction from nearest town or city street address of well if located within city?

5 3/4 South, 1 East of Stafford

2 WATER WELL OWNER: Raymond Oil Co., Inc.

RR#, St. Address, Box # : P.O. Box 48788


City, State, ZIP Code : Wichita, Ks. 67201- 8788

Board of Agriculture, Division of Water Resources

Application Number: 20030188

3 LOCATE WELL'S LOCATION WITH 4 DEPTH OF COMPLETED WELL 78 ft. ELEVATION:

AN "X" IN SECTION BOX:

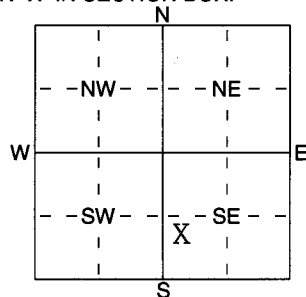

Depth(s) Groundwater Encountered 17 ft. 2 ft. 3 ft. 7-25-03 ft.

WELL'S STATIC WATER LEVEL 17 ft. below land surface measured on mo/day/yr

Pump test data: Well water was N/A ft. after hours pumping gpm

Est. Yield N/A gpm Well water was N/A ft. after hours pumping gpm

WELL WATER TO BE USED AS: 5 Public water supply 8 Air conditioning 11 Injection well

1 Domestic 3 Feedlot 6 Oil field water supply 9 Dewatering 12 Other (Specify below)

2 Irrigation 4 Industrial 7 Domestic (lawn & garden) 10 Monitoring well

Was a chemical/bacteriological sample submitted to Department? Yes No X; If yes, mo/day/yr sample was submitted Water Well Disinfected? Yes HTH No

5 TYPE OF BLANK CASING USED: 5 Wrought iron 8 Concrete tile CASING JOINTS: Glued X Clamped

1 Steel 3 RMP (SR) 6 Asbestos-Cement 9 Other (specify below) Welded

2 PVC 4 ABS 7 Fiberglass Threaded

Blank casing diameter 5 in. to 58 ft. Dia 58 in. to 58 ft. Dia

Casing height above land surface 24 in., weight SDR- 26 lbs./ft. Wall thickness or guage No.

TYPE OF SCREEN OR PERFORATION MATERIAL: 7 PVC 10 Asbestos-Cement

1 Steel 3 Stainless Steel 5 Fiberglass 8 RMP (SR) 11 Other (Specify)

2 Brass 4 Galvanized Steel 6 Concrete tile 9 ABS 12 None used (open hole)

SCREEN OR PERFORATION OPENINGS ARE: 5 Guazed wrapped 8 Saw cut 11 None (open hole)

1 Continuous slot 3 Mill slot 6 Wire wrapped 9 Drilled holes

2 Louvered shutter 4 Key punched 7 Torch cut 10 Other (specify) ft.

SCREEN-PERFORATED INTERVALS: From 78 ft. to 58 ft. From 78 ft. to 58 ft.

GRAVEL PACK INTERVALS: From 78 ft. to 17 ft. From 78 ft. to 17 ft.

From 78 ft. to 17 ft. From 78 ft. to 17 ft.

6 GROUT MATERIAL: 1 Neat cement 2 Cement grout 3 Bentonite 4 Other hole plug

Grout Intervals: From 17 ft. to 0 ft. From 17 ft. to 0 ft.

What is the nearest source of possible contamination: 10 Livestock pens 14 Abandoned water well

1 Septic tank 4 Lateral lines 7 Pit privy 11 Fuel storage 15 Oil well/Gas well

2 Sewer lines 5 Cess pool 8 Sewage lagoon 12 Fertilizer storage 16 Other (specify below)

3 Watertight sewer lines 6 Seepage pit 9 Feedyard 13 Insecticide storage None

Direction from well? How many feet?

FROM TO LITHOLOGIC LOG FROM TO PLUGGING INTERVALS

0 3 Top soil, sandy

3 16 Clay & gravel mix

16 36 Sand & gravel med, loose with a

few small clay streaks

36 41 Ash & tan clay

41 78 Sand & gravel small, med, loose

7 CONTRACTOR'S OR LANDOWNER'S CERTIFICATION: This water well was (1) constructed, (2) reconstructed, or (3) plugged under my jurisdiction and was completed on (mo/day/year) 7-25-03 and this record is true to the best of my knowledge and belief. Kansas Water Well Contractor's Licence No 134 This Water Well Record was completed on (mo/day/yr) 7-30-03 under the business name of Rosencrantz- Bemis by (signature) India Radon