WATER WELL RECORD Form WWC-5 KSA 82a-1212 ID No. _____

1 LOCATION OF WATER WELL: County: Stafford	Fraction: NE ¼ NE ¼ NE ¼	Section Number: 10	Township Number: T 25 S	Range Number: R 11 E/W

Distance and direction from nearest town or city street address of well if located within city? From Zenith 1 South 1 West 3/4 North

2 WATER WELL OWNER: JERRY McMillen

RR#, St. Address, Box # : 421 SE 40th Street

City, State, ZIP Code : Stafford KS 67578

Board of Agriculture, Division of Water Resources Application Number: NA

3 LOCATE WELL'S LOCATION WITH AN "X" IN SECTION BOX:

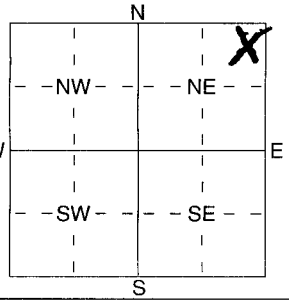

4 DEPTH OF COMPLETED WELL 47 ft. ELEVATION: .....

Depth(s) Groundwater Encountered 1 16 ft. 2 ..... ft. 3 ..... ft.

WELL'S STATIC WATER LEVEL 16 ft. below land surface measured on mo/day/yr 3-24-05

Pump test data: Well water was ..... ft. after ..... hours pumping ..... gpm

Est. Yield ..... gpm: Well water was ..... ft. after ..... hours pumping ..... gpm

WELL WATER TO BE USED AS: 1 Domestic 2 Irrigation 3 Feedlot 4 Industrial 5 Public water supply 6 Oil field water supply 7 Domestic (lawn & garden) 8 Air conditioning 9 Dewatering 10 Monitoring well 11 Injection well 12 Other (Specify below) Stock

Was a chemical/bacteriological sample submitted to Department? Yes ..... No X; If yes, mo/day/yrs sample was submitted

Water Well Disinfected? Yes X No

5 TYPE OF BLANK CASING USED: 1 Steel 2 PVC X 3 RMP (SR) 4 ABS 5 Wrought iron 6 Asbestos-Cement 7 Fiberglass 8 Concrete tile 9 Other (specify below)

CASING JOINTS: Glued X Clamped ..... Welded ..... Threaded .....

Blank casing diameter 5 in. to 47 ft., Dia ..... in. to ..... ft., Dia ..... in. to ..... ft.

Casing height above land surface 24 in., weight 160 lbs./ft. Wall thickness or guage No. .....

TYPE OF SCREEN OR PERFORATION MATERIAL: 1 Steel 2 Brass 3 Stainless Steel 4 Galvanized Steel 5 Fiberglass 6 Concrete tile 7 PVC X 8 RMP (SR) 9 ABS 10 Asbestos-Cement 11 Other (Specify) ..... 12 None used (open hole)

SCREEN OR PERFORATION OPENINGS ARE: X 1 Continuous slot 2 Louvered shutter 3 Mill slot 4 Key punched 5 Guazed wrapped 6 Wire wrapped 7 Torch cut 8 Saw cut 9 Drilled holes 10 Other (specify) ..... 11 None (open hole)

SCREEN-PERFORATED INTERVALS: From 47 ft. to 27 ft., From ..... ft. to ..... ft.

From 47 ft. to ..... ft., From ..... ft. to ..... ft.

GRAVEL PACK INTERVALS: From 47 ft. to 20 ft., From ..... ft. to ..... ft.

From ..... ft. to ..... ft., From ..... ft. to ..... ft.

6 GROUT MATERIAL: 1 Neat cement 2 Cement grout X 3 Bentonite 4 Other .....

Grout Intervals: From 20 ft. to 0 ft., From ..... ft. to ..... ft., From ..... ft. to ..... ft.

What is the nearest source of possible contamination:

1 Septic tank 2 Sewer lines 3 Watertight sewer lines 4 Lateral lines 5 Cess pool 6 Seepage pit 7 Pit privy 8 Sewage lagoon 9 Feedyard 10 Livestock pens 11 Fuel storage 12 Fertilizer storage 13 Insecticide storage X 14 Abandoned water well 15 Oil well/Gas well 16 Other (specify below) .....

Direction from well? North How many feet? 20

FROM	TO	LITHOLOGIC LOG	FROM	TO	PLUGGING INTERVALS
0	3	SANDY Top Soil			
3	12	Tan Clay			
12	25	Coarse Sand			
25	31	Tan Clay			
31	47	Coarse Sand			

7 CONTRACTOR'S OR LANDOWNER'S CERTIFICATION: This water well was (1) X constructed, (2) reconstructed, or (3) plugged under my jurisdiction and was completed on (mo/day/year) 3-24-05 and this record is true to the best of my knowledge and belief. Kansas Water Well Contractor's Licence No 672 This Water Well Record was completed on (mo/day/yr) 3-24-05 under the business name of Crowsis water well by (signature) Tom Crowsis

INSTRUCTIONS: Use typewriter or ball point pen. *PLEASE PRESS FIRMLY* and *PRINT* clearly. Please fill in blanks, underline or circle the correct answers. Send top three copies to Kansas Department of Health and Environment, Bureau of Water, Geology Section, 1000 SW Jackson St., Suite 420, Topeka, Kansas 66612-1367. Telephone 785-296-5522. Send one to WATER WELL OWNER and retain one for your records. Fee of $5.00 for each constructed well.