

1 LOCATION OF WATER WELL:	Fraction	Section Number	Township Number	Range Number
County: <u>Stafford</u>	<u>SW 1/4 NW 1/4 NW 1/4</u>	<u>4</u>	T <u>25</u> S	R <u>11</u> E <u>W</u>

Distance and direction from nearest town or city street address of well if located within city?

3 mi W, 3 $\frac{1}{4}$ S of Zenith


2 WATER WELL OWNER: Mike Sell
RR#, St. Address, Box # : Rt 1, Box 144
City, State, ZIP Code : Safford, KS 67578

Board of Agriculture, Division of Water Resources
Application Number:

3 LOCATE WELL'S LOCATION WITH AN "X" IN SECTION BOX. 4 DEPTH OF COMPLETED WELL. 49 ft. ELEVATION:

AN "X" IN SECTION BOX.

4. DEPTH OF COMPLETED WELL.....49..... ft. ELEVATION:

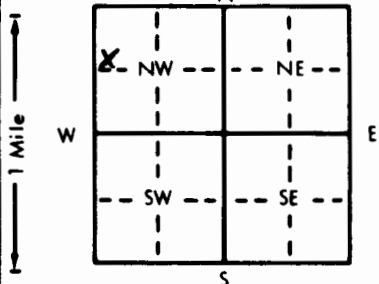

Depth(s) Groundwater Encountered 1. ft. 2. ft. 3. ft.

WELL'S STATIC WATER LEVEL 13 ft. below land surface measured on mo/day/yr 4-18-91

Pump test data: Well water was 17 ft. after 1 hours pumping 30 gpm

Est. Yield gpm: Well water was ft. after hours pumping gpm

Bore Hole Diameter 8 in. to 50 ft., and in. to ft.

WELL WATER TO BE USED AS:

	5 Public water supply	8 Air conditioning	11 Injection well
<u>1</u> Domestic	3 Feedlot	6 Oil field water supply	9 Dewatering
2 Irrigation	4 Industrial	7 Lawn and garden only	10 Monitoring well
			12 Other (Specify below)

Was a chemical/bacteriological sample submitted to Department? Yes No X; If yes, mo/day/yr sample was submitted

Water Well Disinfected? Yes X No

5	TYPE OF BLANK CASING USED:	5 Wrought iron	8 Concrete tile	CASING JOINTS: Glued ☒ Clamped ☐
---	----------------------------	----------------	-----------------	---

1 Steel 3 RMP (SR) 6 Asbestos-Cement 9 Other (specify below) Welded
 @PVC 4 ABS 7 Fiberglass Threaded
 Blank casing diameter 5 in. to 39 ft. Dia. in. to ft. Dia. in. to ft.
 Casing height above land surface 12 in. weight 2.29 lbs./ft. Wall thickness or gauge No. 160

TYPE OF SCREEN OR PERFORATION MATERIAL:			☒ PVC	10 Asbestos-cement
1 Steel	3 Stainless steel	5 Fiberglass	8 RMP (SR)	11 Other (specify)
2 Brass	4 Galvanized steel	6 Concrete tile	9 ABS	12 None used (open hole)

SCREEN OR PERFORATION OPENINGS ARE:

1 Continuous slot	3 Mill slot	5 Gauzed wrapped	8 Saw cut	11 None (open hole)
2 Louvered shutter	4 Key punched	6 Wire wrapped	9 Drilled holes	
		7 Torch cut	10 Other (specify)	

SCREEN-PERFORATED INTERVALS:	From 39	ft. to 49	ft., From	ft. to	ft.
	From	ft. to	ft., From	ft. to	ft.
GRAVEL PACK INTERVALS:	From 15	ft. to 50	ft., From	ft. to	ft.
	From	ft. to	ft., From	ft. to	ft.

6 GROUT MATERIAL: 1 Neat cement 2 Cement grout 3 Bentonite 4 Other
Grout Intervals: From 3 ft. to 15 ft., From ft. to ft., From ft. to ft.

What is the nearest source of possible contamination:

1 Septic tank	4 Lateral lines	7 Pit privy	10 Livestock pens	14 Abandoned water well
2 Sewer lines	5 Cess pool	8 Sewage lagoon	11 Fuel storage	15 Oil well/Gas well
3 Watertight sewer lines	6 Seepage pit	9 Feedyard	12 Fertilizer storage	16 Other (specify below)
			13 Insecticide storage	

Direction from well?		<i>N</i>		How many feet?		<i>70</i>	
FROM	TO	LITHOLOGIC LOG	FROM	TO	PLUGGING INTERVALS		

[illegible]

7 CONTRACTOR'S OR LANDOWNER'S CERTIFICATION: This water well was (1) constructed, (2) reconstructed, or (3) plugged under my jurisdiction and was completed on (mo/day/year) 4-18-91 and this record is true to the best of my knowledge and belief. Kansas Water Well Contractor's License No. 447 This Water Well Record was completed on (mo/day/yr) 6-2-91 under the business name of Miller Drilling by (signature) E. Miller