USE TYPEWRITER OR BALL POINT PEN-PRESS FIRMLY, PRINT CLEARLY.

WATER WELL RECORD
KSA 82a-1201-1215

Kansas Department of Health and Environment-Division of Environment
(Water well Contractors)
Topeka, Kansas 66620

S/2 N/2 N/2

1. Location of well:	County	Fraction	Section number	Township number	Range number
	Stafford	~~W½ NW¼ & E½ NW¼~~ 1/4 1/4 KK	9	T 25 S	R 11 E W

2. Distance and direction from nearest town or city:
7½ miles Southeast of Stafford, KS
Street address of well location if in city:

3. Owner of well: Steve Paulsen
R.R. or street: Route 2
City, state, zip code: Stafford, KS 67578

4. Locate with "X" in section below: Sketch map:

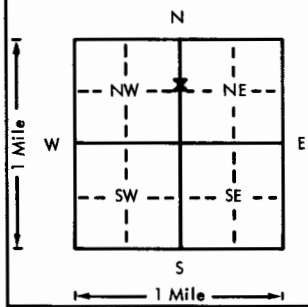

6. Bore hole dia. 24 in. Completion date 9-21-76
Well depth 80 ft.

7. __ Cable tool __ Rotary __ Driven __ Dug
__ Hollow rod __ Jetted __ Bored X Reverse rotary

8. Use: __ Domestic __ Public supply __ Industry
X Irrigation __ Air conditioning __ Stock
__ Lawn __ Oil field water __ Other

9. Casing: Material steel Height: (Above) or below
Threaded __ Welded X Surface 12 in.
RMP __ PVC __ Weight 30.3 lbs./ft.
Dia. 16 in. to 36 ft. depth Wall Thickness: inches or
Dia. __ in. to __ ft. depth gage No. 7 ga.

5. Type and color of material	From	To
top soil & clay	0	4
sand & gravel & thin clay streaks	4	45
soft brown clay	45	47
sand & gravel	47	52
clay	52	54
sand & gravel	54	80

10. Screen: Manufacturer's name Doerr
Type Double slot Dia. 16"
Slot/gauze 1/8" Length 44'
Set between 36 ft. and 80 ft.
ft. and ft.
Gravel pack? yes Size range of material 3/8-200

11. Static water level: mo./day/yr.
17'2" ft. below land surface Date 9-17-76

12. Pumping level below land surfaces: N/C
ft. after hrs. pumping g.p.m.
ft. after hrs. pumping g.p.m.
Estimated maximum yield g.p.m.

13. Water sample submitted: mo./day/yr.
__ Yes X No Date

14. Well head completion:
__ Pitless adapter 12 Inches above grade

15. Well grouted? yes
With: X Neat cement __ Bentonite __ Concrete
Depth: From 0 ft. to 10 ft.

16. Nearest source of possible contamination:
NONE KNOWN
ft. Direction Type
Well disinfected upon completion? __ Yes X No

17. Pump: __ Not installed
Manufacturer's name Berkeley
Model number 1202M-3 HP 60 Volts --
Length of drop pipe 60 ft. capacity 900 g.p.m.
Type:
__ Submersible X Turbine
__ Jet __ Reciprocating
__ Centrifugal __ Other

(Use a second sheet if needed)

18. Elevation:

Topography:
__ Hill
__ Slope
__ Upland
__ Valley

19. Remarks:

20. Water well contractor's certification:
This well was drilled under my jurisdiction and this report is true to the best of my knowledge and belief.
Clarke Well & Equip. Inc. 185
Business name License No.
Address Great Bend, KS 67530
Signed Authorized representative Date 9-22-76

25 10 - 9 S/2 N/2 N/2

Forward the white, blue and pink copies to the Department of Health and Environment

Form WWC-5