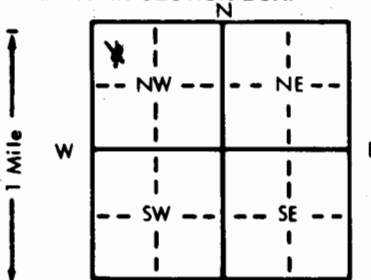


1 LOCATION OF WATER WELL:		Fraction	Section Number	Township Number	Range Number	
County: Stafford		C 1/4 NW 1/4 NW 1/4	10	T 25 S	R 11 X/W	
Distance and direction from nearest town or city street address of well if located within city? 4 miles East, 4 miles South, 1/8 mile East and 1/8 mile South of Stafford.						
2 WATER WELL OWNER: Sterling Drilling Company						
RR#, St. Address, Box #: PO Box 129						
City, State, ZIP Code: Sterling, Kansas 67579						
Board of Agriculture, Division of Water Resources Application Number: T 84-111						
3 LOCATE WELL'S LOCATION WITH AN "X" IN SECTION BOX:		4 DEPTH OF COMPLETED WELL: 65 ft. ELEVATION:				
		Depth(s) Groundwater Encountered 1. ft. 2. ft. 3. ft. WELL'S STATIC WATER LEVEL 15 ft. below land surface measured on mo/day/yr 2-14-84 Pump test data: Well water was ft. after hours pumping gpm Est. Yield gpm: Well water was ft. after hours pumping gpm Bore Hole Diameter in. to ft., and in. to ft. WELL WATER TO BE USED AS: 5 Public water supply 8 Air conditioning 11 Injection well 1 Domestic 3 Feedlot 6 Oil field water supply 9 Dewatering 12 Other (Specify below) 2 Irrigation 4 Industrial 7 Lawn and garden only 10 Observation well Was a chemical/bacteriological sample submitted to Department? Yes.....No.....; If yes, mo/day/yr sample was submitted Water Well Disinfected? Yes No				
5 TYPE OF BLANK CASING USED:						
1 Steel 3 RMP (SR) 5 Wrought iron 8 Concrete tile CASING JOINTS: Glued Clamped 2 PVC 4 ABS 6 Asbestos-Cement 9 Other (specify below) Welded Blank casing diameter in. to ft., Dia in. to ft., Dia in. to ft. Casing height above land surface 3' below ground, weight lbs./ft. Wall thickness or gauge No. TYPE OF SCREEN OR PERFORATION MATERIAL: 7 PVC 10 Asbestos-cement 1 Steel 3 Stainless steel 5 Fiberglass 8 RMP (SR) 11 Other (specify) 2 Brass 4 Galvanized steel 6 Concrete tile 9 ABS 12 None used (open hole) SCREEN OR PERFORATION OPENINGS ARE: 5 Gauzed wrapped 8 Saw cut 11 None (open hole) 1 Continuous slot 3 Mill slot 6 Wire wrapped 9 Drilled holes 2 Louvered shutter 4 Key punched 7 Torch cut 10 Other (specify) SCREEN-PERFORATED INTERVALS: From ft. to ft., From ft. to ft. GRAVEL PACK INTERVALS: From ft. to ft., From ft. to ft. From ft. to ft., From ft. to ft.						
6 GROUT MATERIAL: 1 Neat cement 2 Cement grout 3 Bentonite 4 Other						
Grout Intervals: From 6 ft. to 3 ft., From ft. to ft., From ft. to ft.						
What is the nearest source of possible contamination: 10 Livestock pens 14 Abandoned water well 1 Septic tank 4 Lateral lines 7 Pit privy 11 Fuel storage 15 Oil well/Gas well 2 Sewer lines 5 Cess pool 8 Sewage lagoon 12 Fertilizer storage abandoned 16 Other (specify below) 3 Watertight sewer lines 6 Seepage pit 9 Feedyard 13 Insecticide storage Direction from well? How many feet?						
FROM	TO	LITHOLOGIC LOG		FROM	TO	LITHOLOGIC LOG
65'	15'	Sand & gravel 69.3 cu ft				
15'	6'	Clays 12.5 cu ft				
6'	3'	Cement grout 4.2 cu ft				
7 CONTRACTOR'S OR LANDOWNER'S CERTIFICATION: This water well was (1) constructed, (2) reconstructed, or (3) plugged under my jurisdiction and was completed on (mo/day/year) 2-14-84 and this record is true to the best of my knowledge and belief. Kansas Water Well Contractor's License No. # 151 This Water Well Record was completed on (mo/day/yr) 2-26-84 under the business name of _____ by (signature) Richard J. Mead						
INSTRUCTIONS: Use typewriter or ball point pen, PLEASE PRESS FIRMLY and PRINT clearly. Please fill in blanks, underline or circle the correct answers. Send top three copies to Kansas Department of Health and Environment, Division of Environment, Environmental Geology Section, Topeka, KS 66620. Send one to WATER WELL OWNER and retain one for your records.						