


USE TYPEWRITER OR BALL POINT PEN-PRESS FIRMLY, PRINT CLEARLY.

WATER WELL RECORD
KSA 82a-1201-1215

Kansas Department of Health and Environment-Division of Environment (Water well Contractors) Topeka, Kansas 66620

1. Location of well:	County	Fraction Center	Section number	Township number	Range number
		W ^{1/2} E ^{1/2} NE 1/4	14	T 25 S R	11 E W

2. Distance and direction from nearest town or city: 10 1/2 miles Southeast of Stafford, KS Street address of well location if in city:	3. Owner of well: William E. Goss R.R. or street: P.O. Box 306 City, state, zip code: Stafford, KS 67578
--	---

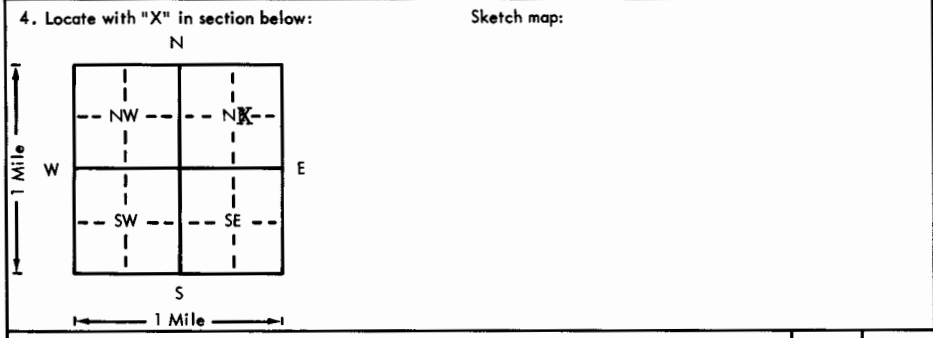

6. Bore hole dia. 24 in. Completion date 6-3-77
Well depth 85 ft.

7. Cable tool Rotary Driven Dug
 Hollow rod Jetted Bored Reverse rotary

8. Use: Domestic Public supply Industry
 Irrigation Air conditioning Stock
 Lawn Oil field water Other

9. Casing: Material steel Height: Above or below
Threaded Welded Surface 12 in.
RMP PVC Weight 30.3 lbs./ft.
Dia. 24 in. to 35 ft. depth; Wall Thickness: inches or
Dia. 24 in. to 57 ft. depth; gage No. 7 ga.

5. Type and color of material	From	To
Top Soil	0	1
Brown & white clay & limestone	1	11
Sand & gravel & clay streak at 23'	11	47
Brown & gray clay & limestone	47	59
Sand & gravel	59	84
Brown clay	84	85

10. Screen: Manufacturer's name Doerr
Type Double-slot Dia. 16"
Slot/gauge 1/8 Length 40'
Set between 35 ft. and 47 ft.
57 ft. and 85 ft.
Gravel pack? yes Size range of material 3/8-200

11. Static water level: _____ mo./day/yr.
10 ft. below land surface Date 5-4-77

12. Pumping level below land surfaces: N/C
_____ ft. after _____ hrs. pumping _____ g.p.m.
_____ ft. after _____ hrs. pumping _____ g.p.m.
Estimated maximum yield _____ g.p.m.

13. Water sample submitted: _____ mo./day/yr.
 Yes No Date 4-4-77

14. Well head completion:
 Pitless adapter 12 inches above grade

15. Well grouted? yes
With: Neat cement Bentonite Concrete
Depth: From 0 ft. to 10 ft.

16. Nearest source of possible contamination: FIELD
ft. _____ Direction _____ Type _____
Well disinfected upon completion? Yes No

17. Pump: _____ Not installed
Manufacturer's name Peerless Pump
Model number 12LB-3 HP 90 Volts _____
Length of drop pipe 60 ft. capacity 900 g.p.m.
Type:
 Submersible Turbine
 Jet Reciprocating
 Centrifugal Other

(Use a second sheet if needed)

18. Elevation:	19. Remarks:	20. Water well contractor's certification: This well was drilled under my jurisdiction and this report is true to the best of my knowledge and belief. Clarke Well & Eq., Inc. 185 Business name License No. _____ Address <u>Great Bend, KS 67530</u> Signed <u>[Signature]</u> Date <u>6-6-77</u> Authorized representative
----------------	--------------	--

25
 11
 14
 Sec 14
 W & E
 1/4