


1-S 1-W OF NEOLA, KS.

Board of Agriculture, Division of Water Resources
Application Number: 93-0232

4 DEPTH OF COMPLETED WELL.....91..... ft. ELEVATION:

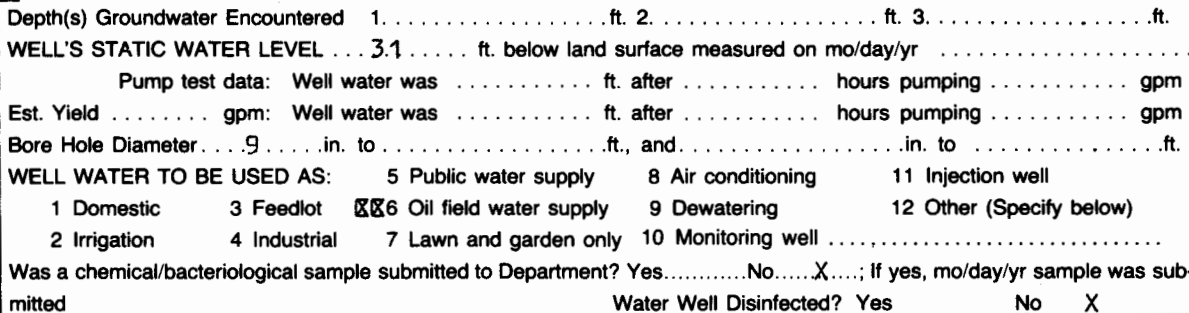

Blank casing diameter 5 in. to 8.1 ft., Dia in. to ft., Dia in. to ft.
Casing height above land surface 12 in., weight lbs./ft. Wall thickness or gauge No.

SCREEN OR PERFORATION OPENINGS ARE:		5 Gauzed wrapped	8 Saw cut	11 None (open hole)
1 Continuous slot	X X Mill slot	6 Wire wrapped	9 Drilled holes	
2 Louvered shutter	4 Key punched	7 Torch cut	10 Other (specify)	

SCREEN-PERFORATED INTERVALS:	From	81	ft. to	91	ft., From		ft. to		ft.
	From		ft. to		ft., From		ft. to		ft.
GRAVEL PACK INTERVALS:	From	20	ft. to	91	ft., From		ft. to		ft.
	From		ft. to		ft., From		ft. to		ft.

6 GROUT MATERIAL: 1 Neat cement 2 Cement grout ~~3~~ ^{xy} Bentonite 4 Other
Grout Intervals: From 0 ft. to 20 ft. From ft. to ft. From ft. to ft.

What is the nearest source of possible contamination:

1 Septic tank	4 Lateral lines	7 Pit privy	10 Livestock pens	14 Abandoned water well
2 Sewer lines	5 Cess pool	8 Sewage lagoon	11 Fuel storage	15 Oil well/Gas well
3 Watertight sewer lines	6 Seepage pit	9 Feedyard	12 Fertilizer storage	16 Other (specify below)
			13 Insecticide storage	NONE

Direction from well? _____ How many feet? _____

[illegible]

7 CONTRACTOR'S OR LANDOWNER'S CERTIFICATION: This water well was x(1) constructed, (2) reconstructed, or (3) plugged under my jurisdiction and was completed on (mo/day/year) JULY 10, 1993 and this record is true to the best of my knowledge and belief. Kansas Water Well Contractor's License No. 46218 This Water Well Record was completed on (mo/day/yr) OCT 13, 1993 under the business name of SAM'S WATER WELL SERVICE by (signature) Don Raderm

INSTRUCTIONS: Use typewriter or ball point pen. PLEASE PRESS FIRMLY and PRINT clearly. Please fill in blanks, underline or circle the correct answers. Send top three copies to Kansas Department of Health and Environment, Bureau of Water, Topeka, Kansas 66620-0001. Telephone: 913-296-5545. Send one to WATER WELL OWNER and retain one for your records.