USE TYPEWRITER OR BALL POINT PEN-PRESS FIRMLY, PRINT CLEARLY.

WATER WELL RECORD
KSA 82a-1201-1215

Kansas Department of Health and Environment-Division of Environment
(Water well Contractors)
Topeka, Kansas 66620

Brock #1

1. Location of well:	County	Fraction	Section number	Township number	Range number
	Stafford	NE 1/4 NE 1/4 NE 1/4	30	T 25 S	R 11 W E/W

2. Distance and direction from nearest town or city: 7 Miles South & 1½ East of Stafford
Street address of well location if in city:

3. Owner of well: Sterling Drilling Co
R.R. or street:
City, state, zip code: Sterling Kansas

4. Locate with "X" in section below:

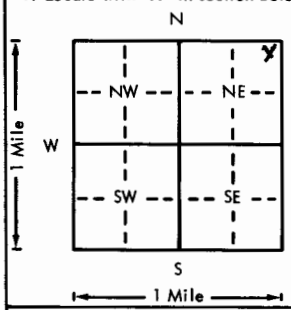

Sketch map:

5. Type and color of material	From	To
Clay	0	10
Sandy Clay	10	20
Sand	20	40
Gravel	40	60

(Use a second sheet if needed)

6. Bore hole dia. 8 in. Completion date 1-18-77
Well depth 60 ft.

7. __ Cable tool X Rotary __ Driven __ Dug
__ Hollow rod __ Jetted __ Bored __ Reverse rotary

8. Use: __ Domestic __ Public supply __ Industry
__ Irrigation __ Air conditioning __ Stock
__ Lawn X Oil field water __ Other

9. Casing: Material Plastic Height: (Above) or below
Threaded __ Welded X Surface 12 in.
RMP __ PVC X Weight 28.73 lbs./ft.
Dia. 5 in. to 60 ft. depth Wall Thickness: inches or
Dia. __ in. to __ ft. depth gage No. 200

10. Screen: Manufacturer's name Self made
Type PVC Dia. 5
Slot/gauze 18 Length 20
Set between 40 ft. and 60 ft.
__ ft. and __ ft.
Gravel pack? yes Size range of material ¼ - ½

11. Static water level: mo./day/yr.
21 ft. below land surface Date 1-18-77

12. Pumping level below land surfaces:
__ ft. after __ hrs. pumping __ g.p.m.
__ ft. after __ hrs. pumping __ g.p.m.
Estimated maximum yield __ g.p.m.

13. X Water sample submitted: mo./day/yr.
__ Yes ✓ No Date

14. Well head completion:
__ Pitless adapter __ Inches above grade

15. Well grouted? yes
With: __ Neat cement X Bentonite __ Concrete
Depth: From 0 ft. to 10 ft.

16. Nearest source of possible contamination: Joint
ft. __ Direction __ Type
Well disinfected upon completion? __ Yes __ No

17. Pump: X Not installed
Manufacturer's name
Model number HP Volts
Length of drop pipe ft. capacity g.p.m.
Type:
__ Submersible __ Turbine
__ Jet __ Reciprocating
__ Centrifugal __ Other

18. Elevation:

Topography:
__ Hill
X Slope
__ Upland
__ Valley

19. Remarks:

20. Water well contractor's certification:
This well was drilled under my jurisdiction and this report is true to the best of my knowledge and belief.
Myers Waterwell
Business name License No.
Address St Bend Ks 143
Signed A Myers Date 1-18-77
Authorized representative

25 T 11 R W 30 Sec NE ¼ NE ¼ NE ¼

Forward the white, blue and pink copies to the Department of Health and Environment

Form WWC-5