

1	LOCATION OF WATER WELL:	Fraction	Section Number	Township Number	Range Number
County:	Stafford	S $\frac{1}{2}$ $\frac{1}{4}$ SE $\frac{1}{4}$ SE $\frac{1}{4}$	31	T 25 S	R 11W E(W)


Distance and direction from nearest town or city street address of well if located within city?

9 S. 2 E of Stafford, Kansas

2	WATER WELL OWNER: Doyle Wilson	H-30 Drilling	Wilson #1
	RR#, St. Address, Box # : Macksville, Ks.	251 N. Water, Suite 10	Board of Agriculture, Division of Water Resources
	City, State, ZIP Code : 67577	Wichita, Kansas 67202	Application Number: T87-530

3 LOCATE WELL'S LOCATION WITH AN "X" IN SECTION BOX:

4 DEPTH OF COMPLETED WELL: 80 ft. ELEVATION: Unknown

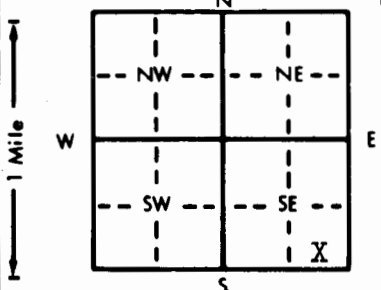

Depth(s) Groundwater Encountered 116 ft. 2. ft. 3. ft.

WELL'S STATIC WATER LEVEL 16 ft. below land surface measured on mo/day/yr 11/14/87

Pump test data: Well water was ft. after hours pumping gpm

Est. Yield ... 60 ... gpm: Well water was ft. after hours pumping gpm

Bore Hole Diameter ... 8 ... in. to 80 ft., and in. to ft.

WELL WATER TO BE USED AS:

5 Public water supply	8 Air conditioning	11 Injection well		
1 Domestic	3 Feedlot	6 <u>Oil field water supply</u>	9 Dewatering	12 Other (Specify below)
2 Irrigation	4 Industrial	7 Lawn and garden only	10 Observation well	

Was a chemical/bacteriological sample submitted to Department? Yes.....No.....; If yes, mo/day/yr sample was submitted

Water Well Disinfected? Yes No

5	TYPE OF BLANK CASING USED:
---	----------------------------

- | | | | | |
|---------|------------|-------------------|-------------------------|----------|
| 1 Steel | 3 RMP (SR) | 5 Asbestos-Cement | 9 Other (specify below) | Welded |
| 2 PVC | 4 ABS | 7 Fiberglass | | Threaded |

Blank casing diameter 5 in. to . 60 ft., Dia in. to ft., Dia in. to ft.

Casing height above land surface 12 in., weight 2.8 lbs./ft. Wall thickness or gauge No. Sch. 40

TYPE OF SCREEN OR PERFORATION MATERIAL:

- | | | | | |
|---------|--------------------|-----------------|------------|--------------------------|
| 1 Steel | 3 Stainless steel | 5 Fiberglass | 8 RMP (SR) | 10 (specify) |
| 2 Brass | 4 Galvanized steel | 6 Concrete tile | 9 ABS | 12 None used (open hole) |

SCREEN OR PERFORATION OPENINGS ARE:

- | | | | |
|--------------------|---------------|----------------|--------------------------|
| 1 Continuous slot | 3 Mill slot | 6 Wire wrapped | 9 Drilled holes |
| 2 Louvered shutter | 4 Kev punched | 7 Torch cut | 10 Other (specify) |

SCREEN-PERFORATED INTERVALS:	From	60	ft. to	80	ft.	From		ft. to		ft.
	From		ft. to		ft.	From		ft. to		ft.
GRAVEL PACK INTERVALS:	From	20	ft. to	80	ft.	From		ft. to		ft.
	From		ft. to		ft.	From		ft. to		ft.

6 GROUT MATERIAL: 1 Neat cement 2 Cement grout 3 Bentonite 4 Other

Grout Intervals: From 0 ft. to 20 ft. From ft. to ft. From ft. to ft.

What is the nearest source of possible contamination:

- | | | | | |
|--------------------------|-----------------|-----------------|------------------------|-----------------------------|
| 1 Septic tank | 4 Lateral lines | 7 Pit privy | 10 Evaporation pond | 14 Hand-dug water well |
| 2 Sewer lines | 5 Cess pool | 8 Sewage lagoon | 11 Fuel storage | 15 <u>Oil well/Gas well</u> |
| 3 Watertight sewer lines | 6 Seepage pit | 9 Feedyard | 12 Fertilizer storage | 16 Other (specify below) |
| | | | 13 Insecticide storage | |

Direction from well? South How many feet? 60

[illegible]

7 CONTRACTOR'S OR LANDOWNER'S CERTIFICATION: This water well was (1) constructed, (2) reconstructed, or (3) plugged under my jurisdiction and was completed on (mo/day/year) 11/14/87. This record is true to the best of my knowledge and belief. Kansas Water Well Contractor's License No. 186. This Water Well Record was completed on (mo/day/yr) 12/14/87 under the business name of Kelly's Water Well Service by (signature) [Signature]