

1 LOCATION OF WATER WELL: County: <u>Stafford</u>		Fraction <u>S/2</u> 1/4 <u>N/2</u> 1/4 <u>NE</u> 1/4	Section Number <u>32</u>	Township Number T <u>25</u> S	Range Number R <u>11</u> E <u>W</u>
--	--	---	-----------------------------	----------------------------------	--


Distance and direction from nearest town or city street address of well if located within city? 2-S, 2-W, of Neola, KS

2 WATER WELL OWNER: *VAL Energy Inc*
RR#, St. Address, Box #: *Box 322*
City, State, ZIP Code: *Haysville, KS 67060*

Board of Agriculture, Division of Water Resources
Application Number: 92-0009

3 LOCATE WELL'S LOCATION WITH AN "X" IN SECTION BOX:

4 DEPTH OF COMPLETED WELL.....90'..... ft. ELEVATION:

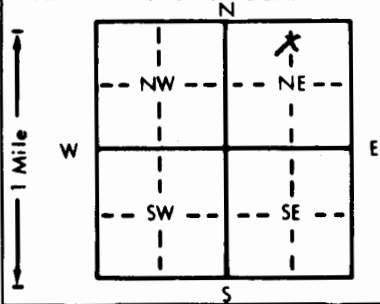

Depth(s) Groundwater Encountered 1. ft. 2. ft. 3. ft.

WELL'S STATIC WATER LEVEL 23 ft. below land surface measured on mo/day/yr

Pump test data: Well water was ft. after hours pumping gpm

Est. Yield gpm: Well water was ft. after hours pumping gpm

Bore Hole Diameter 9 in. to ft. and in. to ft.

WELL WATER TO BE USED AS:

1 Domestic	3 Feedlot	<u>6</u> Oil field water supply	9 Dewatering	11 Injection well
2 Irrigation	4 Industrial	7 Lawn and garden only	10 Monitoring well	12 Other (Specify below)

Was a chemical/bacteriological sample submitted to Department? Yes No X ; If yes, mo/day/yr sample was submitted

Water Well Disinfected? Yes No X

5	TYPE OF BLANK CASING USED:
---	----------------------------

- | | | | | |
|---------|------------|-------------------|-------------------------|----------------|
| 1 Steel | 3 RMP (SR) | 6 Asbestos-Cement | 9 Other (specify below) | Welded |
| 2 PVC | 4 ABS | 7 Fiberglass | | Threaded |

Blank casing diameter . . . 5 . . . in. to . . . 80 . . . ft., Dia . . . in. to . . . ft., Dia . . . in. to . . . ft.
Casing height above land surface . . . 12 . . . in., weight . . . lbs./ft. Wall thickness or gauge No.

TYPE OF SCREEN OR PERFORATION MATERIAL:

- | | | | | |
|---------|--------------------|-----------------|------------|--------------------------|
| 1 Steel | 3 Stainless steel | 5 Fiberglass | 8 RMP (SR) | 11 Other (specify) |
| 2 Brass | 4 Galvanized steel | 6 Concrete tile | 9 ABS | 12 None used (open hole) |

SCREEN OR PERFORATION OPENINGS ARE:

- 1 Continuous slot ☒ Mill slot 6 Wire wrapped 9 Drilled holes
2 Louvered shutter 4 Key punched 7 Torch cut 10 Other (specify)

SCREEN-PERFORATED INTERVALS: From 80 ft. to 90 ft. From _____ ft. to _____ ft.
From _____ ft. to _____ ft. From _____ ft. to _____ ft.

GRAVEL PACK INTERVALS: From 20 ft. to 90 ft., From _____ ft. to _____ ft.
From _____ ft. to _____ ft., From _____ ft. to _____ ft.

6 GROUT MATERIAL: 1 Neat cement 2 Cement grout 3 Bentonite 4 Other

Grout Intervals: From 0 ft. to 20 ft., From _____ ft. to _____ ft., From _____ ft. to _____ ft.

- What is the nearest source of possible contamination:
- | | | | | |
|--------------------------|-----------------|-----------------|------------------------|--------------------------|
| 1 Septic tank | 4 Lateral lines | 7 Pit privy | 10 Livestock pens | 14 Abandoned water well |
| 2 Sewer lines | 5 Cess pool | 8 Sewage lagoon | 11 Fuel storage | 15 Oil well/Gas well |
| 3 Watertight sewer lines | 6 Seepage pit | 9 Feedyard | 12 Fertilizer storage | 16 Other (specify below) |
| | | | 13 Insecticide storage | NONE |

Direction from well?	How many feet?
----------------------	----------------

[illegible]

7 CONTRACTOR'S OR LANDOWNER'S CERTIFICATION: This water well was (1) constructed, (2) reconstructed, or (3) plugged under my jurisdiction and was completed on (mo/day/year) 1-27-92 and this record is true to the best of my knowledge and belief. Kansas Water Well Contractor's License No. 462-B This Water Well Record was completed on (mo/day/yr) 7-3-92 under the business name of Same Water Well by (signature) Bill Brown / VAK Energy