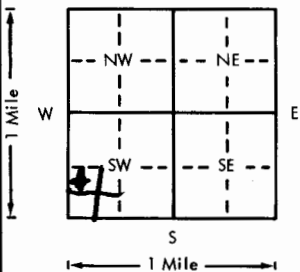


USE TYPEWRITER OR BALL
POINT PEN-PRESS FIRMLY,
PRINT CLEARLY.

WATER WELL RECORD
KSA 82a-1201-1215

Kansas Department of Health and
Environment-Division of Environment
(Water well Contractors)
Topeka, Kansas 66620

1. Location of well:		County Stafford	Fraction NW 1/4 SW 1/4	Section number 33	Township number 25	Range number 11	E
2. Distance and direction from nearest town or city 4 1/2 miles NE Preston				3. Owner of well: Ralph McCarty R.R. or street: Preston, Ks. City, state, zip code:			
4. Locate with "X" in section below: 				Sketch map:			
5. Type and color of material				From	To	6. Bore hole dia 8 in. Completion date 4-27-79 Well depth 72 ft.	
soil				0	5	7. Cable tool ☒ Rotary ☐ Driven ☐ Dug ☐ Hollow rod ☐ Jetted ☐ Bored ☐ Reverse rotary	
clay				5	45	8. Use: ☒ Domestic ☐ Public supply ☐ Industry ☐ Irrigation ☐ Air conditioning ☐ Stock ☐ Lawn ☐ Oil field water ☐ Other	
med - coarse sand silty fine sand				45	49	9. Casing: Material ☐ Height: above or below Threaded ☐ Welded ☐ Surface 20 in. RMP ☐ PVC ☒ Weight 12.12 lbs./ft. Dia. 5 in. to 72 ft. depth Wall thickness 258 inches or Dia. ☐ in. to ☐ ft. depth gage No.	
medium, coarse sand				49	72	10. Screen: Manufacturer's name Pumpco Type pvc Dia. 5 Slot/gauze 0.25 Length 5 Set between 67 ft. and 72 ft. ft. and ☐ ft. Gravel pack? ☒ Size range of material 3/4 in	
						11. Static water level: ☐ mo./day/yr. 38 ft. below land surface Date 4-9-79	
						12. Pumping level below land surfaces: ft. after ☐ hrs. pumping ☐ g.p.m. ft. after ☐ hrs. pumping ☐ g.p.m. Estimated maximum yield 50 g.p.m.	
						13. Water sample submitted: ☐ Yes ☒ No Date ☐ mo./day/yr.	
						14. Well head completion: ☐ Pitless adapter 20 inches above grade	
						15. Well grouted? ☒ With: ☐ Neat cement ☐ Bentonite ☒ Concrete Depth: From 0 ft. to 10 ft.	
						16. Nearest source of possible contamination: ft. W Direction 100 Type garden Well disinfected upon completion? ☒ Yes ☐ No	
						17. Pump: ☐ Not installed Manufacturer's name ☐ Model number ☐ HP ☐ Volts ☐ Length of drop pipe 54 ft. capacity 5 g.p.m. Type: ☐ Submersible ☐ Turbine ☐ Jet ☒ Reciprocating ☐ Centrifugal ☐ Other	
(Use a second sheet if needed)							
18. Elevation:		19. Remarks:		20. Water well contractor's certification: This well was drilled under my jurisdiction and this report is true to the best of my knowledge and belief. Lyman Bros. 140 Business name License No. Address Med Lodge Ks. Signed W H Lyman Date 4-28-79 Authorized representative			
Topography: ☐ Hill ☒ Slope ☐ Upland ☐ Valley							