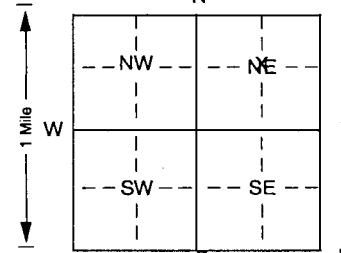


1 LOCATION OF WATER WELL:		Fraction		Section Number		Township Number		Range Number	
County: Stafford		1/4 NC 1/4 NE 1/4		10		T 25 S		R 12 E W	
Distance and direction from nearest town or city street address of well if located within city? Approximately 4 1/4 miles south and 1 1/4 miles west of Stafford									
2 WATER WELL OWNER: Lawrence Debes RR#, St. Address, Box # : 517 Rush City, State, ZIP Code : Larned, KS 67550 Board of Agriculture, Division of Water Resources Application Number: 44,563									
3 LOCATE WELL'S LOCATION WITH AN "X" IN SECTION BOX:		4 DEPTH OF COMPLETED WELL 120 ft. ELEVATION: unknown							
		Depth(s) Groundwater Encountered 1 ft. 2 ft. 3 ft.							
		WELL'S STATIC WATER LEVEL 16 ft. below land surface measured on mo/day/yr 1-25-02							
		Pump test data: Well water was not checked ft. after hours pumping gpm							
		Est. Yield unknown gpm: Well water was ft. after hours pumping gpm							
		Bore Hole Diameter 24 in. to 120 ft., and in. to ft.							
		WELL WATER TO BE USED AS: 5 Public water supply 8 Air conditioning 11 Injection well							
		1 Domestic 3 Feedlot 6 Oil field water supply 9 Dewatering 12 Other (specify below)							
		2 Irrigation 4 Industrial 7 Domestic (lawn & garden) 10 Monitoring well							
		Was a chemical/bacteriological sample submitted to Department? Yes No If yes, mo/day/yr sample was submitted							
		Water Well Disinfected? Yes No							
5 TYPE OF BLANK CASING USED: 5 Wrought iron 8 Concrete tile CASING JOINTS: Glued Clamped									
1 Steel 3 RMP (SR) 6 Asbestos-Cement 9 Other (specify below) Welded									
2 PVC 4 ABS 7 Fiberglass Threaded									
Blank casing diameter 16 in. to 69 ft., Dia in. to ft., Dia in. to ft.									
Casing height above land surface 12 in., weight 16.15 lbs./ft. Wall thickness or gauge No 500									
TYPE OF SCREEN OR PERFORATION MATERIAL: 7 PVC 10 Asbestos-cement									
1 Steel 3 Stainless steel 5 Fiberglass 8 RMP (SR) 11 Other (specify)									
2 Brass 4 Galvanized steel 6 Concrete tile 9 ABS 12 None used (open hole)									
SCREEN OR PERFORATION OPENINGS ARE: 5 Gauzed wrapped 8 Saw cut 11 None (open hole)									
1 Continuous slot 3 Mill slot 6 Wire wrapped 9 Drilled holes									
2 Louvered shutter 4 Key punched 7 Torch cut 10 Other (specify)									
SCREEN-PERFORATED INTERVALS: From 69 ft. to 119 ft., From ft. to ft.									
GRAVEL PACK INTERVALS: From 22 ft. to 120 ft., From ft. to ft.									
6 GROUT MATERIAL: 1 Neat cement 2 Cement grout 3 Bentonite 4 Other									
Grout Intervals: From 0 ft. to 22 ft., From ft. to ft., From ft. to ft.									
What is the nearest source of possible contamination: 10 Livestock pens 14 Abandoned water well									
1 Septic tank 4 Lateral lines 7 Pit privy 11 Fuel storage 15 Oil well/Gas well									
2 Sewer lines 5 Cess pool 8 Sewage lagoon 12 Fertilizer storage 16 Other (specify below)									
3 Watertight sewer lines 6 Seepage pit 9 Feedyard 13 Insecticide storage None known									
Direction from well? How many feet?									
FROM TO LITHOLOGIC LOG FROM TO PLUGGING INTERVALS									
0 3 Topsoil									
3 21 Clay, tan									
21 23 Sand and gravel, fine, medium, coarse									
23 26 Clay, white									
26 41 Sand and gravel, fine, medium, coarse									
41 55 Clay, brown with gravel streaks									
55 68 Clay, gray									
68 120 Sand and gravel, fine, medium, loose, clean									
7 CONTRACTOR'S OR LANDOWNER'S CERTIFICATION: This water well was (1) constructed, (2) reconstructed, or (3) plugged under my jurisdiction and was completed on (mo/day/year) 1-25-02 and this record is true to the best of my knowledge and belief. Kansas Water Well Contractor's License No 185 This Water Well Record was completed on (mo/day/yr) 2-4-02 under the business name of Clarke Well & Equipment, Inc. by (signature)									
INSTRUCTIONS: Use typewriter or ball point pen. PLEASE PRESS FIRMLY and PRINT clearly. Please fill in blanks, underline or circle the correct answers. Send top three copies to Kansas Department of Health and Environment, Bureau of Water, Topeka, Kansas 66620-0001. Telephone 785-296-5524. Send one to WATER WELL OWNER and retain one for your records. Fee of \$5.00 for each constructed well.									