WATER WELL RECORD Form WWC-5 KSA 82a-1212 ID No. _____

1 LOCATION OF WATER WELL: County: Stafford	Fraction NW ¼ NW ¼ NW ¼	Section Number 15	Township Number T 25 S	Range Number R 12w E/W

Distance and direction from nearest town or city street address of well if located within city?
5S, 2W of Stafford, Ks.

2 WATER WELL OWNER: Mary Margeret Boyles — Sterling Drilling Co. — Stanton Farms 1-15
RR#, St. Address, Box # : 807 N. Main — P. O. Box 1006 — Board of Agriculture, Division of Water Resources
City, State, ZIP Code : St. John, Ks 67576 — Pratt, Ks. 67124 — Application Number:

3 LOCATE WELL'S LOCATION WITH AN "X" IN SECTION BOX:

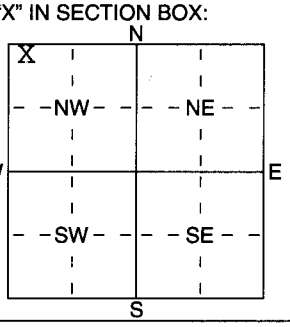

4 DEPTH OF COMPLETED WELL 103 ft. ELEVATION: unknown
Depth(s) Groundwater Encountered 1 20 ft. 2 ____ ft. 3 ____ ft.
WELL'S STATIC WATER LEVEL 20 ft. below land surface measured on mo/day/yr 11/18/03
Pump test data: Well water was ____ ft. after ____ hours pumping ____ gpm
Est. Yield 60 gpm: Well water was ____ ft. after ____ hours pumping ____ gpm
WELL WATER ~~TO BE~~ WAS USED AS: 5 Public water supply 8 Air conditioning 11 Injection well
1 Domestic 3 Feedlot 6 Oil field water supply 9 Dewatering 12 Other (Specify below)
2 Irrigation 4 Industrial ~~7 Domestic (lawn & garden)~~ 10 Monitoring well

Was a chemical/bacteriological sample submitted to Department? Yes ~~No~~; If yes, mo/day/yrs sample was submitted
Water Well Disinfected? Yes No

5 TYPE OF BLANK CASING USED: 5 Wrought iron 8 Concrete tile CASING JOINTS: ~~Glued~~ Clamped
1 Steel 3 RMP (SR) 6 Asbestos-Cement 9 Other (specify below) Welded
2 PVC 4 ABS 7 Fiberglass Threaded
Blank casing diameter 5 in. to 83 ft., Dia ____ in. to ____ ft., Dia ____ in. to ____ ft.
Casing height above land surface 3 ft. below in., weight ____ lbs./ft. Wall thickness or guage No. ____
TYPE OF SCREEN OR PERFORATION MATERIAL: 7 PVC 10 Asbestos-Cement
1 Steel 3 Stainless Steel 5 Fiberglass ~~8 RMP~~ (SR) 11 Other (Specify) ____
2 Brass 4 Galvanized Steel 6 Concrete tile 9 ABS 12 None used (open hole)
SCREEN OR PERFORATION OPENINGS ARE: 5 Guazed wrapped 8 Saw cut 11 None (open hole)
1 Continuous slot 3 Mill slot 6 Wire wrapped ~~9 Drilled holes~~
2 Louvered shutter 4 Key punched 7 Torch cut 10 Other (specify) ____ ft.
SCREEN-PERFORATED INTERVALS: From 83 ft. to 103 ft., From ____ ft. to ____ ft.
From ____ ft. to ____ ft., From ____ ft. to ____ ft.
GRAVEL PACK INTERVALS: From 30 ft. to 55 ft., From 60 ft. to 103 ft.
From ____ ft. to ____ ft., From ____ ft. to ____ ft.

6 GROUT MATERIAL: 1 Neat cement 2 Cement grout 3 Bentonite 4 Other ____
Grout Intervals: From 3 ft. to 30 ft., From ~~33~~ 45 ft. to ~~XXXX~~ 70 ft., From ____ ft. to ____ ft.
What is the nearest source of possible contamination: 10 Livestock pens 14 Abandoned water well
1 Septic tank 4 Lateral lines 7 Pit privy 11 Fuel storage 15 Oil well/Gas well
2 Sewer lines 5 Cess pool 8 Sewage lagoon 12 Fertilizer storage 16 Other (specify below)
3 Watertight sewer lines 6 Seepage pit 9 Feedyard 13 Insecticide storage ____
Direction from well? East How many feet? 100

FROM	TO	LITHOLOGIC LOG	FROM	TO	PLUGGING INTERVALS
			103	70	sand and gravel
			70	45	grout
			45	30	sand and gravel
			30	3	grout
			3	0	top soil

7 CONTRACTOR'S OR LANDOWNER'S CERTIFICATION: This water well was (1) constructed, (2) reconstructed, or (3) plugged under my jurisdiction and was completed on (mo/day/year) 11/18/03 and this record is true to the best of my knowledge and belief. Kansas Water Well Contractor's Licence No 186 This Water Well Record was completed on (mo/day/yr) 11/19/03
under the business name of Kelly's Water Well Service, Inc. by (signature) Kathryn R Head

INSTRUCTIONS: Use typewriter or ball point pen. *PLEASE PRESS FIRMLY* and *PRINT* clearly. Please fill in blanks, underline or circle the correct answers. Send top three copies to Kansas Department of Health and Environment, Bureau of Water, Geology Section, 1000 SW Jackson St., Suite 420, Topeka, Kansas 66612-1367. Telephone 785-296-5522. Send one to WATER WELL OWNER and retain one for your records. Fee of $5.00 for each constructed well.