


1	LOCATION OF WATER WELL:	Fraction	SE	SE	SE	Section Number	Township Number	Range Number
	Stafford		SE 1/4	SE 1/4	SE 1/4	9	T 25 S	R 12W E/W

Distance and direction from nearest town or city street address of well if located within city?

5 S, 2 E of Stafford, Kansas

2	WATER WELL OWNER:	John Staton	Red Tiger Drilling
	RR#, St. Address, Box # :	St. John, Ks.	1720 Ks. St. Bank Bldg. Board of Agriculture, Division of Water Resources
	City, State, ZIP Code :	67576	Wichita, Ks. 67202 Application Number: T82-651

3	LOCATE WELL'S LOCATION WITH AN "X" IN SECTION BOX:	4	DEPTH OF COMPLETED WELL: 123	ft.	ELEVATION: Unknown
---	--	---	------------------------------	-----	--------------------

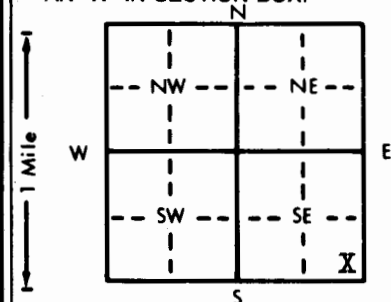

4 DEPTH OF COMPLETED WELL: 123 ft. ELEVATION: Unknown

Depth(s) Groundwater Encountered 1. 30 ft. 2. _____ ft. 3. _____ ft.

WELL'S STATIC WATER LEVEL 30 ft. below land surface measured on mo/day/yr 12/7/82

Pump test data: Well water was _____ ft. after _____ hours pumping _____ gpm

Est. Yield 60 gpm: Well water was _____ ft. after _____ hours pumping _____ gpm

Bore Hole Diameter 8 in. to 123 ft., and _____ in. to _____ ft.

WELL WATER TO BE USED AS:

1 Domestic	3 Feedlot	6 <u>Oil field water supply</u>	8 Air conditioning	11 Injection well
2 Irrigation	4 Industrial	7 Lawn and garden only	10 Observation well	12 Other (Specify below)

Was a chemical/bacteriological sample submitted to Department? Yes _____ No _____; If yes, mo/day/yr sample was submitted _____

Water Well Disinfected? Yes _____ No _____

5	TYPE OF BLANK CASING USED:		5 Wrought iron	8 Concrete tile	CASING JOINTS: <u>Glued</u> Clamped Welded Threaded
	1 Steel	3 RMP (SR)	6 Asbestos-Cement	9 Other (specify below)	
	2 PVC	4 ABS	7 Fiberglass		

Blank casing diameter 5 in. to 103 ft., Dia in. to ft., Dia in. to ft.
Casing height above land surface 12 in. weight 2.8 lbs./ft. Wall thickness or gauge No. Sch. 40

TYPE OF SCREEN OR PERFORATION MATERIAL:			7 <u>PVC</u>	10 Asbestos-cement
1 Steel	3 Stainless steel	5 Fiberglass	8 RMP (SR)	11 Other (specify)
2 Brass	4 Galvanized steel	6 Concrete tile	9 ABS	12 None used (open hole)

SCREEN OR PERFORATION OPENINGS ARE:		5 Gauzed wrapped	<u>8 Saw cut</u>	11 None (open hole)
1 Continuous slot	3 Mill slot	6 Wire wrapped	9 Drilled holes	
2 Louvered shutter	4 Key punched	7 Torch cut	10 Other (specify)	

SCREEN-PERFORATED INTERVALS:	From	103	ft. to	123	ft.,	From	ft. to	ft.
	From		ft. to		ft.,	From	ft. to	ft.
GRAVEL PACK INTERVALS:	From	10	ft. to	123	ft.,	From	ft. to	ft.
	From		ft. to		ft.,	From	ft. to	ft.

6] GROUT MATERIAL: 1 Neat cement 2 Cement grout 3 Bentonite 4 Other
Grout Intervals: From 0 ft to 10 ft From ft to ft From ft to ft

What is the nearest source of possible contamination:

1 Septic tank	4 Lateral lines	7 Pit privy	10 Livestock pens	14 Abandoned water well
2 Sewer lines	5 Cess pool	8 Sewage lagoon	11 Fuel storage	15 <u>Oil well/Gas well</u>
3 Watertight sewer lines	6 Seepage pit	9 Feedyard	12 Fertilizer storage	16 Other (specify below)
Direction from well?	South		13 Insecticide storage	
			How many feet?	60

[illegible]

7 CONTRACTOR'S OR LANDOWNER'S CERTIFICATION: This water well was (1) constructed, (2) reconstructed, or (3) plugged under my jurisdiction and was completed on (mo/day/year) 12/7/82 and this record is true to the best of my knowledge and belief. Kansas Water Well Contractor's License No. 186 This Water Well Record was completed on (mo/day/yr) 1/11/83 under the business name of Kellys Water Well Service by (signature) George Road

INSTRUCTIONS: Use typewriter or ball point pen, PLEASE PRESS FIRMLY and PRINT clearly. Please fill in blanks, underline or circle the correct answers. Send top three copies to Kansas Department of Health and Environment, Division of Environment, Environmental Geology Section, Topeka, KS 66620. Send one to WATER WELL OWNER and retain one for your records.