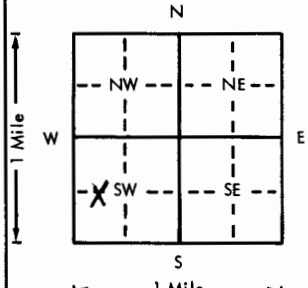


USE TYPEWRITER OR BALL
POINT PEN-PRESS FIRMLY,
PRINT CLEARLY.

WATER WELL RECORD
KSA 82a-1201-1215

Kansas Department of Health and
Environment-Division of Environment
(Water well Contractors)
Topeka, Kansas 66620

1. Location of well:		County STAFFORD	Fraction C/SW 1/4 1/4 1/4 1/4	Section number 1	Township number 25 T S R	Range number 12 1 2 3
2. Distance and direction from nearest town or city: 3 1/4 S of Stafford Street address of well location if in city:			3. Owner of well: Virgil Rice R.R. or street: City, state, zip code: STAFFORD, KS.			
4. Locate with "X" in section below:			Sketch map:		6. Bore hole dia. 29 in. Completion date Well depth 48 ft. 5-20-76	
					7. Cable tool <input checked="" type="checkbox"/> Rotary <input type="checkbox"/> Driven <input type="checkbox"/> Dug <input type="checkbox"/> Hollow rod <input type="checkbox"/> Jetted <input type="checkbox"/> Bored <input type="checkbox"/> Reverse rotary	
5. Type and color of material			From	To	8. Use: <input type="checkbox"/> Domestic <input type="checkbox"/> Public supply <input type="checkbox"/> Industry <input checked="" type="checkbox"/> Irrigation <input type="checkbox"/> Air conditioning <input type="checkbox"/> Stock <input type="checkbox"/> Lawn <input type="checkbox"/> Oil field water <input type="checkbox"/> Other	
Sandy Top Soil			0	1/2	9. Casing: Material steel Height: Above or below Threaded <input type="checkbox"/> Welded <input type="checkbox"/> Surface 18 in. RMP <input type="checkbox"/> PVC <input type="checkbox"/> Weight <input type="checkbox"/> lbs./ft. Dia. 16 in. to 48 ft. depth Wall Thickness: inches or Dia. <input type="checkbox"/> in. to <input type="checkbox"/> ft. depth gage No. 1	
Brown Clay			1/2	6	10. Screen: Manufacturer's name Doerr Type steel Dia. 16 Slot/gauze 3/16 Length 16 Set between 32 ft. and 48 ft. Gravel pack? <input checked="" type="checkbox"/> Size range of material 1/2 3/4 5/8	
Gravel & Clay			6	24	11. Static water level: <input type="checkbox"/> mo./day/yr. 17 ft. below land surface Date 4-5-76	
Sand & Gravel			24	28	12. Pumping level below land surfaces: 10 ft. after 1 hrs. pumping 400 g.p.m. ft. after <input type="checkbox"/> hrs. pumping <input type="checkbox"/> g.p.m. Estimated maximum yield 500 g.p.m.	
Clay			28	28 1/2	13. Water sample submitted: <input type="checkbox"/> Yes <input type="checkbox"/> No Date 4-5-76	
Sand & Gravel			28 1/2	47	14. Well head completion: <input type="checkbox"/> Pitless adapter <input type="checkbox"/> inches above grade	
Clay			47	70	15. Well grouted? <input checked="" type="checkbox"/> With: <input type="checkbox"/> Neat cement <input type="checkbox"/> Bentonite <input checked="" type="checkbox"/> Concrete Depth: From 0 ft. to 10 ft.	
Green Clay			70	73	16. Nearest source of possible contamination: ft. 5 m Direction N Type Septic Well disinfected upon completion? <input type="checkbox"/> Yes <input type="checkbox"/> No	
Sand			73	76	17. Pump: <input type="checkbox"/> Not installed Manufacturer's name WAB Model number 4CM10 HP 20 Volts <input type="checkbox"/> Length of drop pipe 40 ft. capacity 400 g.p.m. Type: <input type="checkbox"/> Submersible <input checked="" type="checkbox"/> Turbine <input type="checkbox"/> Jet <input type="checkbox"/> Reciprocating <input type="checkbox"/> Centrifugal <input type="checkbox"/> Other	
Clay			76	77	18. Elevation:	
Sand			77	90	19. Remarks:	
Gravel			90	96	20. Water well contractor's certification: This well was drilled under my jurisdiction and this report is true to the best of my knowledge and belief. Rosencrantz-Bemis 134 Business name License No. Address Great Bend, KS. Signed Frederic Rosencrantz Date 9/30/76 Authorized representative	
Shale			96		18. Elevation: Topography: <input type="checkbox"/> Hill <input type="checkbox"/> Slope <input checked="" type="checkbox"/> Upland <input type="checkbox"/> Valley	
(Use a second sheet if needed)						

25
120
1
1/4
1/4
C/SW