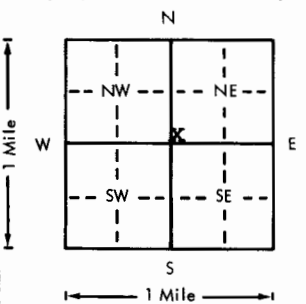


USE TYPEWRITER OR BALL
POINT PEN-PRESS FIRMLY,
PRINT CLEARLY.

WATER WELL RECORD
KSA 82a-1201-1215

Kansas Department of Health and
Environment-Division of Environment
(Water well Contractors)
Topeka, Kansas 66620

1. Location of well:		County Stafford	Fraction SW 1/4 SW 1/4 ne 1/4	Section number 5-2512	Township number 25 S	Range number R 12 E/W
2. Distance and direction from nearest town or city: 3-S 3 1/2-W of Stafford, KS Street address of well location if in city:				3. Owner of well: H-30 Drilling Co. R.R. or street: 200 N. Main St. City, state, zip code: Wichita, Ks. 67202		
4. Locate with "X" in section below:		Sketch map:		6. Bore hole dia. 8 in. Completion date _____ Well depth 90 ft. 7-7-75		
				7. ☐ Cable tool ☒ Rotary ☐ Driven ☐ Dug ☐ Hollow rod ☐ Jetted ☐ Bored ☐ Reverse rotary		
5. Type and color of material		From		To		8. Use: ☐ Domestic ☐ Public supply ☐ Industry ☐ Irrigation ☐ Air conditioning ☐ Stock ☐ Lawn ☒ Oil field water ☐ Other
sandy top soil		0		1 1/2		9. Casing: Material pvc Height: Above or below Threaded _____ Welded _____ Surface 18 in. RMP _____ PVC ☒ Weight _____ lbs./ft. Dia. 4 in. to 90 ft. depth Wall Thickness: inches or Dia. _____ in. to _____ ft. depth gage No. 237
clay		1 1/2		21		10. Screen: Manufacturer's name CertainTeed Type pvc Dia. _____ Slot/groove 1/16 Length 30 Set between 60 ft. and 90 ft. _____ ft. and _____ ft. Gravel pack? ☒ Size range of material 3/4 3/8
sand & gravel		21		26		11. Static water level: _____ mo./day/yr. 18 ft. below land surface Date 7-7-75
clay		26		40		12. Pumping level below land surfaces: na _____ ft. after _____ hrs. pumping _____ g.p.m. _____ ft. after _____ hrs. pumping _____ g.p.m. Estimated maximum yield _____ g.p.m.
sand & gravel		40		60		13. Water sample submitted: _____ mo./day/yr. Yes ☐ No ☒ Date _____
clay		60		72		14. Well head completion: ☐ Pitless adapter _____ Inches above grade
gold sand & gravel		72		88		15. Well grouted? no With: _____ Neat cement _____ Bentonite _____ Concrete Depth: From _____ ft. to _____ ft.
clay		88		90		16. Nearest source of possible contamination: ft. 2 mi Direction West Type Septic Well disinfected upon completion? ☒ Yes _____ No
(Use a second sheet if needed)						17. Pump: ☒ Not installed Manufacturer's name _____ Model number _____ HP _____ Volts _____ Length of drop pipe _____ ft. capacity _____ g.p.m. Type: ☐ Submersible ☐ Turbine ☐ Jet ☐ Reciprocating ☐ Centrifugal ☐ Other
18. Elevation:		19. Remarks:				20. Water well contractor's certification: This well was drilled under my jurisdiction and this report is true to the best of my knowledge and belief. Rosencrantz-Bemis 134 Business name License No. Address Great Bend, Kansas 67530 Signed J. L. Kilgore Date 7-21-79 Authorized representative
Topography: ☐ Hill ☐ Slope ☒ Upland ☐ Valley						