


USE TYPEWRITER OR BALL POINT PEN-PRESS FIRMLY, PRINT CLEARLY.

WATER WELL RECORD
KSA 82a-1201-1215

Kansas Department of Health and Environment-Division of Environment (Water well Contractors) Topeka, Kansas 66620

1. Location of well: County Stafford Fraction 1/4 NE 1/4 Section number 6 Township number T 25 S Range number R 12 E

2. Distance and direction from nearest town or city: 4W 3 1/4 S of Stafford
Street address of well location if in city:
3. Owner of well: Mrs Glenn Reed
R.R. or street:
City, state, zip code: Stafford, Ks.

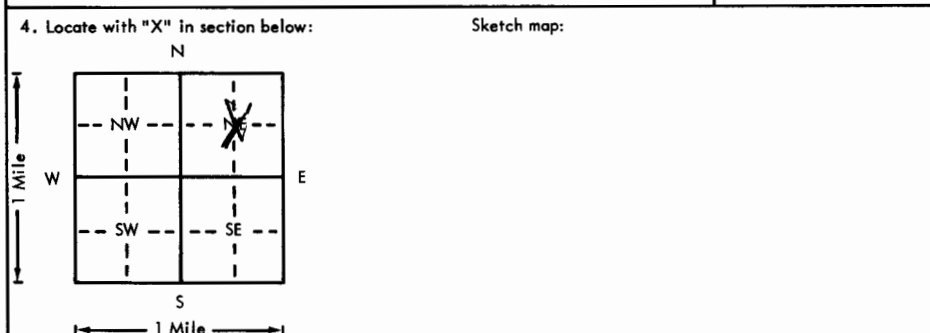

6. Bore hole dia. 2 1/2 in. Completion date 11-18-74
Well depth 153 ft.
7. Cable tool Rotary Driven Dug
 Hollow rod Jetted Bored Reverse rotary
8. Use: Domestic Public supply Industry
 Irrigation Air conditioning Stock
 Lawn Oil field water Other
9. Casing: Material steel Height: Above or below
Threaded Welded Surface 18 in.
RMP PVC Weight lbs./ft.
Dia 1 1/2 in. to 153 ft. depth Wall Thickness: inches or
Dia. in. to ft. depth Gage No. 7

5. Type and color of material	From	To
Sandy Top Soil	0	2
Brown Sandy Clay	2	15
Brown & Gray Tough Clay	15	28
Fine Sand	28	34
Blue Gray-Brown & White Clay	34	40
Tough Brown & White Clay	40	45
Sandy Brown & White Clay	45	55
Sand & Gravel loose Med. Clean	55	73
Brown Clay	73	95
Sand & Gravel	95	99
Brown & White Clay & Sand Mixed	99	105
Sand & Gravel lot of Clay	105	110
Sand & Gravel Med. loose	110	116
Brown Clay & Sand streaks	116	131
Sand & Gravel Clean Coarse loose	131	153
Red Bed. (Use a second sheet if needed)	153	

10. Screen: Manufacturer's name Doerr
Type steel Dia. 1 1/2
Stor/gauge 3/16 Length 44
Set between 109 ft. and 153 ft.
Gravel pack? Size range of material 1/2 3/4 3/8
11. Static water level: 10 ft. below land surface Date 8-23-79 mo./day/yr.
12. Pumping level below land surfaces:
21 ft. after 1 hrs. pumping 1200 g.p.m.
 ft. after hrs. pumping g.p.m.
Estimated maximum yield 1400 g.p.m.
13. Water sample submitted: Yes No Date 8-23-79 mo./day/yr.
14. Well head completion:
 Pitless adapter Inches above grade
15. Well grouted?
With: Neat cement Bentonite Concrete
Depth: From 0 ft. to 10 ft.
16. Nearest source of possible contamination:
ft. 2 Direction n Type Corral
Well disinfected upon completion? Yes No
17. Pump: Not installed
Manufacturer's name WLB
Model number 50M12 HP 60 Volts
Length of drop pipe 85 ft. capacity g.p.m.
Type: Submersible Turbine
 Jet Reciprocating
 Centrifugal Other

18. Elevation:
Topography:
 Hill
 Slope
 Upland
 Valley

19. Remarks:

20. Water well contractor's certification:
This well was drilled under my jurisdiction and this report is true to the best of my knowledge and belief.
Rosenkrantz - Benn's 134
Business name License No.
Address Great Bend, Ks.
Signed Tricia Anderson Date 9/30/76
Authorized representative

25 120 6 1/4 1/4 CNE