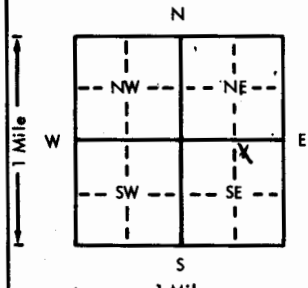


USE TYPEWRITER OR BALL
POINT PEN-PRESS FIRMLY,
PRINT CLEARLY.

WATER WELL RECORD
KSA 82a-1201-1215

Kansas Department of Health and
Environment-Division of Environment
(Water well Contractors)
Topeka, Kansas 66620

X Location of well:		County <u>Stafford</u>	Fraction <u>NW 1/4 7E 1/4 SE 1/4</u>	Section number <u>7</u>	Township number <u>T. 25 S</u>	Range number <u>R. 12 W</u>
2. Distance and direction from nearest town or city: <u>25.46 miles from Stafford</u>		3. Owner of well: <u>State Building Co.</u>		R.R. or street: <u>Great Bend Kansas</u>		
Street address of well location if in city: <u>4501 W. 1/2 south</u>		City, state, zip code: <u>Great Bend Kansas</u>				
4. Locate with "X" in section below:		Sketch map:		6. Bore hole dia. <u>5</u> in. Completion date <u>7-12-76</u> Well depth <u>60</u> ft.		
				7. Cable tool <input checked="" type="checkbox"/> Rotary <input type="checkbox"/> Driven <input type="checkbox"/> Dug <input type="checkbox"/> Hollow rod <input type="checkbox"/> Jetted <input type="checkbox"/> Bored <input type="checkbox"/> Reverse rotary		
8. Type and color of material		From		To		8. Use: <input type="checkbox"/> Domestic <input type="checkbox"/> Public supply <input type="checkbox"/> Industry <input type="checkbox"/> Irrigation <input type="checkbox"/> Air conditioning <input type="checkbox"/> Stock <input type="checkbox"/> Lawn <input checked="" type="checkbox"/> Oil field water <input type="checkbox"/> Other
Soil		0		5		9. Casing: Material <u>Plastic</u> Height: Above or below Threaded <input type="checkbox"/> Welded <input checked="" type="checkbox"/> Surface <u>12</u> in. RMP <input type="checkbox"/> PVC <input checked="" type="checkbox"/> Weight <u>7.6</u> lbs./ft. Dia. <u>2</u> in. to <u>60</u> ft. depth Wall Thickness: inches or Dia. <u>2</u> in. to <u>60</u> ft. depth gage No. <u>40-154</u>
Sandy Clay		5		20		10. Screen: Manufacturer's name <u>Shirley</u> Type <u>slot</u> Dia. <u>2</u> Slot/gauze <u>1/8</u> Length <u>10</u> Set between <u>50</u> ft. and <u>60</u> ft. ft. and <u>60</u> ft. Gravel pack? <input checked="" type="checkbox"/> Size range of material <u>1/8</u> <u>1/4</u>
Fine Sand		20		45		11. Static water level: <u>14</u> ft. below land surface Date <u>7-12-76</u> mo./day/yr.
Gravel		45		60		12. Pumping level below land surfaces: <u>30</u> ft. after <u>1</u> hrs. pumping <u>80</u> g.p.m. ft. after <u> </u> hrs. pumping <u> </u> g.p.m. Estimated maximum yield <u>100 gal</u> g.p.m.
						13. Water sample submitted: <u>1</u> mo./day/yr. Yes <input checked="" type="checkbox"/> No <input type="checkbox"/> Date <u> </u>
						14. Well head completion: <input type="checkbox"/> Pitless adapter <u>12</u> inches above grade
						X Well grouted? <input checked="" type="checkbox"/> With: <input checked="" type="checkbox"/> Neat cement <input checked="" type="checkbox"/> Bentonite <input type="checkbox"/> Concrete Depth: From <u>0</u> ft. to <u>10</u> ft.
						16. Nearest source of possible contamination: ft. <u> </u> Direction <u> </u> Type <u> </u> Well disinfected upon completion? <input type="checkbox"/> Yes <input type="checkbox"/> No
						17. Pump: <input checked="" type="checkbox"/> Not installed Manufacturer's name <u> </u> Model number <u> </u> HP <u> </u> Volts <u> </u> Length of drop pipe <u> </u> ft. capacity <u> </u> g.p.m. Type: <input type="checkbox"/> Submersible <input type="checkbox"/> Turbine <input type="checkbox"/> Jet <input type="checkbox"/> Reciprocating <input type="checkbox"/> Centrifugal <input type="checkbox"/> Other
						20. Water well contractor's certification: This well was drilled under my jurisdiction and this report is true to the best of my knowledge and belief. <u>Representative Well Service</u> Business name <u>Great Bend Kansas</u> License No. <u>143</u> Address <u> </u> Signed <u> </u> Date <u>7-12</u> Authorized representative
18. Elevation:		19. Remarks:				
Topography: <input type="checkbox"/> Hill <input checked="" type="checkbox"/> Slope <input type="checkbox"/> Upland <input type="checkbox"/> Valley						

25-1201-7-NW-SE
T 25 S R 12 W