


4 3/4 S. & 2 1/2 W. DESTAFFORD, KS.

Application Number: 93-0119

4 DEPTH OF COMPLETED WELL... 100..... ft. ELEVATION:

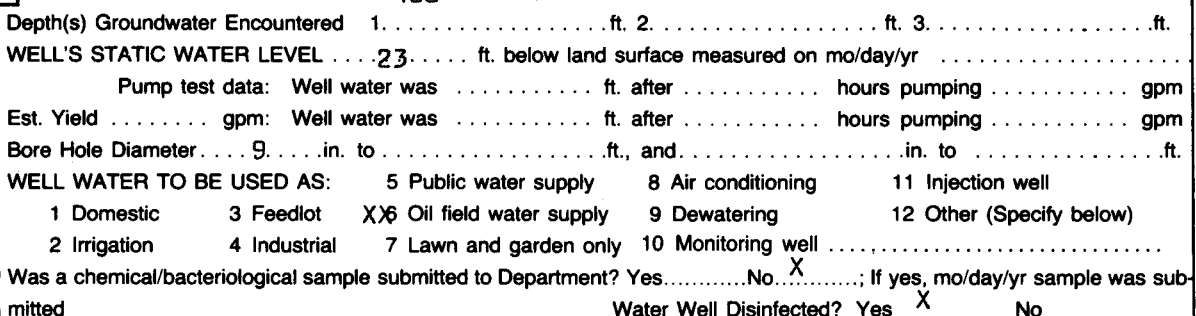

6 GROUT MATERIAL:		1 Neat cement	2 Cement grout	XX8 Bentonite	4 Other
Grout Intervals:		From 0 ft. to 20 ft.	From ft. to ft.	From ft. to ft.	From ft. to ft.
What is the nearest source of possible contamination:			10 Livestock pens		
1 Septic tank	4 Lateral lines	7 Pit privy	11 Fuel storage	14 Abandoned water well	
2 Sewer lines	5 Cess pool	8 Sewage lagoon	12 Fertilizer storage	15 Oil well/Gas well	
3 Watertight sewer lines	6 Seepage pit	9 Feedyard	13 Insecticide storage	16 Other (specify below)	
Direction from well?			... NONE		
			How many feet?		

[illegible]

7 CONTRACTOR'S OR LANDOWNER'S CERTIFICATION: This water well was X1 constructed, (2) reconstructed, or (3) plugged under my jurisdiction and was completed on (mo/day/year) 4-23-93 and this record is true to the best of my knowledge and belief. Kansas Water Well Contractor's License No. 462-B This Water Well Record was completed on (mo/day/yr) 6-17-93 under the business name of SAM'S WATER WELL SERVICE by (signature) [Signature]