USE TYPEWRITER OR BALL POINT PEN-PRESS FIRMLY, PRINT CLEARLY.

WATER WELL RECORD
KSA 82a-1201-1215

Kansas Department of Health and Environment-Division of Environment
(Water well Contractors)
Topeka, Kansas 66620

1. Location of well:	County	Fraction	Section number	Township number	Range number
	Stafford	NE 1/4 ~~SE~~ 1/4 NE 1/4	11	T 25 S	R 12 E/~~W~~

2. Distance and direction from nearest town or city: 4 miles South of Stafford, KS
Street address of well location if in city:

3. Owner of well: Doug McClure
R.R. or street: Route 1
City, state, zip code: Stafford, KS 67578

4. Locate with "X" in section below: Sketch map:

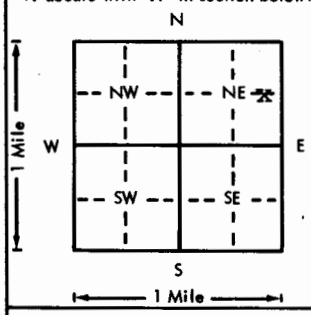

6. Bore hole dia. 24 in. Completion date 4-14-76
Well depth 51 ft.

7. __ Cable tool __ Rotary __ Driven __ Dug
__ Hollow rod __ Jetted __ Bored X Reverse rotary

8. Use: __ Domestic __ Public supply __ Industry
X Irrigation __ Air conditioning __ Stock
__ Lawn __ Oil field water __ Other

9. Casing: Material Steel Height: Above or below
Threaded __ Welded X Surface 12 in.
RMP __ PVC __ Weight 30.3 lbs./ft.
Dia. 16 in. to 31 ft. depth Wall Thickness: inches or
Dia. __ in. to __ ft. depth gage No. 7 ga.

5. Type and color of material	From	To
Sandy top soil	0	3
Sandy clay & sand streaks	3	12
XX Brown & white clay & limestone	12	22
Sand & gravel	22	50
Brown clay	50	51

10. Screen: Manufacturer's name W. A. Brown
Type X Double-slot Dia. 16"
Slot/gauze 1/8 Length 20'
Set between 31 ft. and 51 ft.
ft. and ft.
Gravel pack? Yes Size range of material 3/8-200

11. Static water level: mo./day/yr.
14 ft. below land surface Date 2/26/76

12. Pumping level below land surfaces: N/C
ft. after hrs. pumping g.p.m.
ft. after hrs. pumping g.p.m.
Estimated maximum yield g.p.m.

13. Water sample submitted: mo./day/yr.
__ Yes X No Date

14. Well head completion:
__ Pitless adapter 12 Inches above grade

15. Well grouted? Yes
With: X Neat cement __ Bentonite __ Concrete
Depth: From 0 ft. to 10 ft.

16. Nearest source of possible contamination:
NONE KNOWN
ft. Direction Type
Well disinfected upon completion? __ Yes X No

17. Pump: __ Not installed
Manufacturer's name FMC Corp./Peerless
Model number 10LB-5 HP 25 Volts 460
Length of drop pipe 40 ft. capacity 400 g.p.m.
Type:
__ Submersible X Turbine
__ Jet __ Reciprocating
__ Centrifugal __ Other

(Use a second sheet if needed)

18. Elevation:
Topography:
__ Hill
__ Slope
__ Upland
__ Valley

19. Remarks:
This is a manifold system. The other well has not been completed as of this date. It will be sent upon completion and marked "This is a manifold system.".

20. Water well contractor's certification:
This well was drilled under my jurisdiction and this report is true to the best of my knowledge and belief.
Clarke Well & Equip. Inc. 185
Business name License No.
Address Great Bend, KS 67530
Signed Authorized representative Date 4-16-76

25 T 12 W R 11 Sec NE 1/4 NE 1/4 SE 1/4

Forward the white, blue and pink copies to the Department of Health and Environment

Form WWC-5