USE TYPEWRITER OR BALL POINT PEN-PRESS FIRMLY, PRINT CLEARLY.

WATER WELL RECORD
KSA 82a-1201-1215

Kansas Department of Health and Environment-Division of Environment
(Water well Contractors)
Topeka, Kansas 66620

1. Location of well:	County	Fraction	Section number	Township number	Range number
	Stafford	~~SW~~ 1/4 C 1/4 SW 1/4	16	T 25 S	R 12 ~~E~~/W

2. Distance and direction from nearest town or city: 2 3/4 mi. W. & 6 1/4 mi. S of Stafford, Ks
Street address of well location if in city:

3. Owner of well:
R.R. or street:
City, state, zip code: Tom Turner, Stafford, Kansas 67578

4. Locate with "X" in section below: Sketch map:

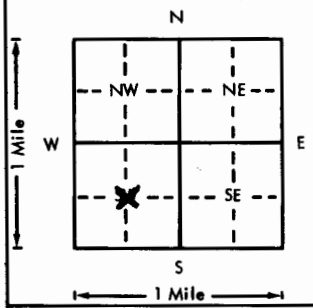

Well No. 1 (TH 1-76)

5. Type and color of material	From	To
Soil	0	2
Brown clay	2	18
Gray clay	18	25
Med. to coarse sand	25	35
Brown clay	35	49
Med. to coarse sand & gravel	49	62
Gray clay	62	65
Med. to coarse sand & gravel	65	105

(Use a second sheet if needed)

6. Bore hole dia. 30 in. Completion date
Well depth 100 ft. 5/8/76

7. __ Cable tool __ Rotary __ Driven __ Dug
__ Hollow rod __ Jetted __ Bored X Reverse rotary

8. Use: __ Domestic __ Public supply __ Industry
X Irrigation __ Air conditioning __ Stock
__ Lawn __ Oil field water __ Other

9. Casing: Material Stl. Height: Above ~~or below~~
Threaded ___ Welded X Surface 12 in.
RMP ___ PVC ___ Weight 36.91 lbs./ft.
Dia. 16 in. to 45 ft. depth Wall Thickness: inches or
Dia. ___ in. to ___ ft. depth gage No. .219"

10. Screen: Manufacturer's name Doerr Metal Products
Type Stl. Dia. 16"
Slot/gauze 1/8" Length 56'
Set between 44 ft. and 100 ft.
___ ft. and ___ ft.
Gravel pack? yes Size range of material 1/8 x 1/4

11. Static water level: mo./day/yr.
11.6 ft. below land surface Date 6/15/76

12. Pumping level below land surfaces:
18.0 ft. after 2 hrs. pumping 800 g.p.m.
___ ft. after ___ hrs. pumping ___ g.p.m.
Estimated maximum yield 800 g.p.m.

13. Water sample submitted: mo./day/yr.
__ Yes X No Date

14. Well head completion: Steel Plate
__ Pitless adapter 12 Inches above grade

15. Well grouted? Yes
With: __ Neat cement __ Bentonite X Concrete
Depth: From 0 ft. to 10 ft.

16. Nearest source of possible contamination:
ft. 2600 Direction S Type Farm
Well disinfected upon completion? X Yes __ No

17. Pump: __ Not installed
Manufacturer's name Layne & Bowler
Model number 12 KL HP 60 Volts
Length of drop pipe 80 ft. capacity 800 g.p.m.
Type:
__ Submersible X Turbine
__ Jet __ Reciprocating
__ Centrifugal __ Other

18. Elevation:
Topography:
__ Hill
__ Slope
X Upland
__ Valley

19. Remarks:

20. Water well contractor's certification:
This well was drilled under my jurisdiction and this report is true to the best of my knowledge and belief.
Layne Western Co. 102
Business name License No.
Address Wichita, Kansas
Signed [signature] Date 6/24/76
Authorized Representative

T 25 R 12 E Sec 16 1/4 1/4 1/4 C SW

Forward the white, blue and pink copies to the Department of Health and Environment

Form WWC-5