


1 LOCATION OF WATER WELL:					Fraction	Section Number			Township Number	Range Number
County:	Stafford	NW	$\frac{1}{4}$ SW	$\frac{1}{4}$ SE	$\frac{1}{4}$	32	12 T	25	S	R 12W E/W

Distance and direction from nearest town or city street address of well if located within city?

S, 3 W of St. John, Kansas

2 WATER WELL OWNER:	Red Tiger Drilling Co.	
RR#, St. Address, Box # :	1720 Kansas State Bank Bldg.	Board of Agriculture, Division of Water Resources
City, State, ZIP Code :	Wichita, Kansas 67202	Application Number: T81-708

3 LOCATE WELL'S LOCATION WITH AN "X" IN SECTION BOX: 4 DEPTH OF COMPLETED WELL: 67 ft. ELEVATION: Unknown
Depth(s) Groundwater Encountered 1 15 ft 2 ft 3 ft

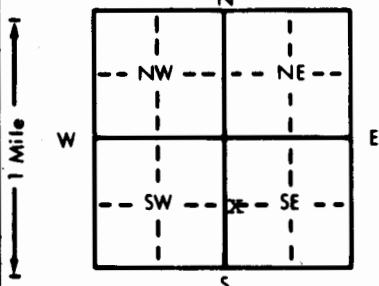

4. DEPTH OF COMPLETED WELL. 67 ft. ELEVATION: Unknown

Depth(s) Groundwater Encountered 1. 15 ft. 2. _____ ft. 3. _____ ft.

WELL'S STATIC WATER LEVEL 15 ft. below land surface measured on mo/day/yr 9/23/81

Pump test data: Well water was _____ ft. after _____ hours pumping _____ gpm

Est. Yield 60 gpm: Well water was _____ ft. after _____ hours pumping _____ gpm

Bore Hole Diameter 8 in. to 67 ft., and _____ in. to _____ ft.

WELL WATER TO BE USED AS:

1 Domestic	3 Feedlot	6 <u>Oil field water supply</u>	9 Dewatering	12 Other (Specify below)
2 Irrigation	4 Industrial	7 Lawn and garden only	10 Observation well	

Was a chemical/bacteriological sample submitted to Department? Yes _____ No _____; If yes, mo/day/yr sample was submitted _____

Water Well Disinfected? Yes _____ No _____

5 TYPE OF BLANK CASING USED:		5 Wrought iron	8 Concrete tile	CASING JOINTS: <u>Glued</u>	Clamped
1 Steel	3 RMP (SR)	6 Asbestos-Cement	9 Other (specify below)	Welded	
2 PVC	4 ABS	7 Fiberglass		Threaded	
Blank casing diameter 5 in. to 47 ft., Dia		 in. to ft., Dia		 in. to ft.	
Casing height above land surface 12 in. weight 2.8		lbs./ft. Wall thickness or gauge No.		Sch. 40	

TYPE OF SCREEN OR PERFORATION MATERIAL:			<u>7 PVC</u>	10 Asbestos-cement
1 Steel	3 Stainless steel	5 Fiberglass	8 RMP (SR)	11 Other (specify)
2 Brass	4 Galvanized steel	6 Concrete tile	9 ABS	12 None used (open hole)

SCREEN OR PERFORATION OPENINGS ARE:		5 Gauzed wrapped	<u>8 Saw cut</u>	11 None (open hole)
1 Continuous slot	3 Mill slot	6 Wire wrapped	9 Drilled holes	
2 Louvered shutter	4 Key punched	7 Torch cut	10 Other (specify)	

SCREEN-PERFORATED INTERVALS:	From	47	ft. to	57	ft., From	ft. to	ft.
	From		ft. to		ft., From	ft. to	ft.
GRAVEL PACK INTERVALS:	From	10	ft. to	67	ft., From	ft. to	ft.
	From		ft. to		ft., From	ft. to	ft.

6 GROUT MATERIAL: 1 Neat cement 2 Cement grout 3 Bentonite 4 Other
Grout Intervals: From 0 ft. to 10 ft. From ft. to ft. From ft. to ft.

What is the nearest source of possible contamination:

1 Septic tank	4 Lateral lines	7 Pit privy	10 Livestock pens	14 Abandoned water well
2 Sewer lines	5 Cess pool	8 Sewage lagoon	11 Fuel storage	15 <u>Oil well/Gas well</u>
3 Watertight sewer lines	6 Seepage pit	9 Feedyard	12 Fertilizer storage	16 Other (specify below)
			13 Insecticide storage	

Direction from well?		East		How many feet? 60	
FROM	TO	LITHOLOGIC LOG	FROM	TO	LITHOLOGIC LOG

[illegible]

7 CONTRACTOR'S OR LANDOWNER'S CERTIFICATION: This water well was (1) constructed, (2) reconstructed, or (3) plugged under my jurisdiction and was completed on (mo/day/year) 9/23/81 and this record is true to the best of my knowledge and belief. Kansas Water Well Contractor's License No. 186 This Water Well Record was completed on (mo/day/yr) 10/29/81

under the business name of Kellys Water Wells by (signature) Steve Ross
INSTRUCTIONS: Use typewriter or ball point pen, PLEASE PRESS FIRMLY and PRINT clearly. Please fill in blanks, underline or circle the correct answers. Send top three copies to Kansas Department of Health and Environment, Division of Environment, Environmental Geology Section, Topeka, KS 66620. Send one to WATER WELL OWNER and retain one for your records.