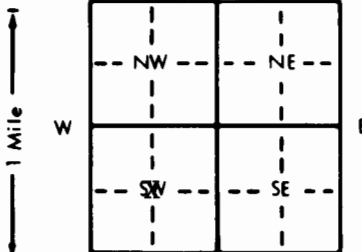


1 LOCATION OF WATER WELL:		Fraction		Section Number		Township Number		Range Number	
County: <u>Stafford</u>		<u>1/4</u> <u>NC</u> <u>1/4</u> <u>SW</u> <u>1/4</u>		<u>28</u>		<u>T</u> <u>25</u> <u>S</u>		<u>R</u> <u>13</u> <u>W</u>	
Distance and direction from nearest town or city street address of well if located within city?									
<u>Approximately 10 1/2 miles south of St. John</u>									
2 WATER WELL OWNER:		Roger Russell							
RR#, St. Address, Box # :		Route 2							
City, State, ZIP Code :		St. John, KS 67576							
Board of Agriculture, Division of Water Resources									
Application Number: <u>16,458</u>									
3 LOCATE WELL'S LOCATION WITH AN "X" IN SECTION BOX:		4 DEPTH OF COMPLETED WELL: <u>120</u> ft. ELEVATION: <u>unknown</u>							
		Depth(s) Groundwater Encountered 1. ft. 2. ft. 3. ft.							
		WELL'S STATIC WATER LEVEL <u>10.5</u> ft. below land surface measured on mo/day/yr <u>4-30-97</u>							
		Pump test data: Well water was <u>not ch'd</u> ft. after hours pumping gpm							
		Est. Yield <u>unknown</u> gpm: Well water was ft. after hours pumping gpm							
		Bore Hole Diameter <u>24</u> in. to <u>120</u> ft., and in. to ft.							
WELL WATER TO BE USED AS:									
5 Public water supply 8 Air conditioning 11 Injection well									
1 Domestic 3 Feedlot 6 Oil field water supply 9 Dewatering 12 Other (Specify below)									
2 <u>Irrigation</u> 4 Industrial 7 Lawn and garden only 10 Monitoring well									
Was a chemical/bacteriological sample submitted to Department? Yes.....No. <u>X</u>; If yes, mo/day/yr sample was submitted									
Water Well Disinfected? Yes No <u>X</u>									
5 TYPE OF BLANK CASING USED:									
1 Steel 3 RMP (SR) 5 Wrought iron 8 Concrete tile CASING JOINTS: Glued <u>X</u> Clamped									
2 PVC 4 ABC 6 Asbestos-Cement 9 Other (specify below) Welded									
7 Fiberglass Threaded									
Blank casing diameter <u>16</u> in. to <u>53</u> ft., Dia <u>16</u> in. to <u>98</u> ft., Dia in. to ft.									
Casing height above land surface <u>24</u> in., weight <u>16.15</u> lbs./ft. Wall thickness or gauge No. <u>500</u>									
TYPE OF SCREEN OR PERFORATION MATERIAL:									
1 Steel 3 Stainless steel 5 Fiberglass 7 PVC 10 Asbestos-cement									
2 Brass 4 Galvanized steel 6 Concrete tile 8 RMP (SR) 11 Other (specify)									
9 ABS 12 None used (open hole)									
SCREEN OR PERFORATION OPENINGS ARE:									
1 Continuous slot 3 Mill slot 5 Gauzed wrapped 8 Saw cut 11 None (open hole)									
2 Louvered shutter 4 Key punched 6 Wire wrapped 9 Drilled holes									
7 Torch cut 10 Other (specify)									
SCREEN-PERFORATED INTERVALS: From <u>53</u> ft. to <u>73</u> ft., From ft. to ft.									
From <u>98</u> ft. to <u>118</u> ft., From ft. to ft.									
GRAVEL PACK INTERVALS: From <u>20</u> ft. to <u>120</u> ft., From ft. to ft.									
From ft. to ft., From ft. to ft.									
6 GROUT MATERIAL:									
1 Neat cement 2 Cement grout 3 Bentonite 4 Other									
Grout Intervals: From <u>0</u> ft. to <u>20</u> ft., From ft. to ft., From ft. to ft.									
What is the nearest source of possible contamination:									
1 Septic tank 4 Lateral lines 7 Pit privy 10 Livestock pens 14 Abandoned water well									
2 Sewer lines 5 Cess pool 8 Sewage lagoon 11 Fuel storage 15 Oil well/Gas well									
3 Watertight sewer lines 6 Seepage pit 9 Feedyard 12 Fertilizer storage 16 Other (specify below)									
13 Insecticide storage None known									
Direction from well? How many feet?									
FROM TO LITHOLOGIC LOG FROM TO PLUGGING INTERVALS									
0 3 Topsoil									
3 21 Clay, brown, sandy with some white									
21 50 Sand and gravel, fine, medium									
50 60 Sand and gravel, fine, medium, coarse									
60 73 Sand and gravel, fine, medium									
73 98 Clay, brown with sand streaks									
98 118 Sand and gravel, fine, medium,									
118 120 Clay, brown									
7 CONTRACTOR'S OR LANDOWNER'S CERTIFICATION: This water well was (1) <u>constructed</u> , (2) reconstructed, or (3) plugged under my jurisdiction and was completed on (mo/day/year) <u>4-30-97</u> and this record is true to the best of my knowledge and belief. Kansas Water Well Contractor's License No. <u>185</u> This Water Well Record was completed on (mo/day/yr) <u>5-16-97</u> under the business name of <u>Clarke Well & Equipment, Inc.</u> by (signature) <u>[Signature]</u>									
INSTRUCTIONS: Use typewriter or ball point pen. PLEASE PRESS FIRMLY and PRINT clearly. Please fill in blanks, underline or circle the correct answers. Send top three copies to Kansas Department of Health and Environment, Bureau of Water, Topeka, Kansas 66620-0001. Telephone: 913-296-5545. Send one to WATER WELL OWNER and retain one for your records.									