


1	LOCATION OF WATER WELL:	Fraction	Section Number	Township Number	Range Number
County:	Stafford	SE ¼ SE ¼ SE ¼	1	T 25 S	R 13 E W

Distance and direction from nearest town or city street address of well if located within city?

4 miles south, 4½ west of Stafford, Ks.

2	WATER WELL OWNER:	Carol Frisbie	
	RR#, St. Address, Box # :	915 S. Pioneer Ave	Board of Agriculture, Division of Water Resources
	City, State, ZIP Code :	Lyons, Ks. 67554	Application Number: SFWW0894

3 LOCATE WELL'S LOCATION WITH AN "X" IN SECTION BOX: 4 DEPTH OF COMPLETED WELL.....7.0..... ft. ELEVATION:
 Depth(s) Groundwater Encountered 1 ft 2 ft 3 ft

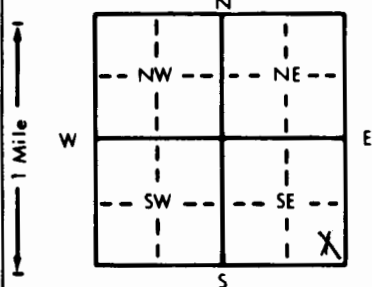

4 DEPTH OF COMPLETED WELL.....7.0.....ft. ELEVATION:.....
 Depth(s) Groundwater Encountered 1.....ft. 2.....ft. 3.....ft.
 WELL'S STATIC WATER LEVEL.....2.1.....ft. below land surface measured on mo/day/yr.....3-27-98.....
 Pump test data: Well water was.....ft. after.....hours pumping.....gpm
 Est. Yield.....na.....gpm: Well water was.....ft. after.....hours pumping.....gpm
 Bore Hole Diameter.....9.....in. to.....7.0.....ft., and.....in. to.....ft.
 WELL WATER TO BE USED AS: 5 Public water supply 8 Air conditioning 11 Injection well
 1 Domestic 3 Feedlot 6 Oil field water supply 9 Dewatering 12 Other (Specify below)
 2 Irrigation 4 Industrial 7 Lawn and garden only 10 Monitoring well.....live stock.....
 Was a chemical/bacteriological sample submitted to Department? Yes.....No.....X.....; If yes, mo/day/yr sample was submitted
 Water Well Disinfected? Yes hth No

5 TYPE OF BLANK CASING USED:		6 Wrought iron		8 Concrete tile		CASING JOINTS: Glued ☒ Clamped ☐	
1 Steel	3 RMP (SR)	6 Asbestos-Cement	9 Other (specify below)			Welded ☐	
2 PVC	4 ABS	7 Fiberglass				Threaded ☐	
Blank casing diameter <u>5</u> in. to <u>50</u> ft., Dia							
Casing height above land surface <u>2</u> in., weight		SDR <u>26</u>		lbs./ft. Wall thickness or gauge No.			
TYPE OF SCREEN OR PERFORATION MATERIAL:							
1 Steel	3 Stainless steel	5 Fiberglass	7 PVC	10 Asbestos-cement			
2 Brass	4 Galvanized steel	6 Concrete tile	8 RMP (SR)	11 Other (specify)			
				9 ABS		12 None used (open hole)	
SCREEN OR PERFORATION OPENINGS ARE:							
1 Continuous slot	3 Mill slot	5 Gauzed wrapped	8 Saw cut	11 None (open hole)			
2 Louvered shutter	4 Key punched	6 Wire wrapped	9 Drilled holes				
				10 Other (specify)			
SCREEN-PERFORATED INTERVALS:		From <u>50</u> ft. to <u>70</u> ft.		From <u> </u> ft. to <u> </u> ft.			
		From <u> </u> ft. to <u> </u> ft.		From <u> </u> ft. to <u> </u> ft.			
GRAVEL PACK INTERVALS:		From <u>70</u> ft. to <u>20</u> ft.		From <u> </u> ft. to <u> </u> ft.			
		From <u> </u> ft. to <u> </u> ft.		From <u> </u> ft. to <u> </u> ft.			

6. GROUT MATERIAL: 1 Neat cement 2 Cement grout 3 Bentonite 4 Other hole plug
Grout Intervals: From 20 ft. to 0 ft., From ft. to ft., From ft. to ft.
What is the nearest source of possible contamination:
1 Septic tank 4 Lateral lines 7 Pit privy 10 Livestock pens 14 Abandoned water well
2 Sewer lines 5 Cess pool 8 Sewage lagoon 11 Fuel storage 15 Oil well/Gas well
3 Watertight sewer lines 6 Seepage pit 9 Feedyard 12 Fertilizer storage 16 Other (specify below)
13 Insecticide storage
Direction from well? east How many feet? 300'

[illegible]

7 CONTRACTOR'S OR LANDOWNER'S CERTIFICATION: This water well was (1) constructed, (2) reconstructed, or (3) plugged under my jurisdiction and was completed on (mo/day/year) 3-27-98 and this record is true to the best of my knowledge and belief. Kansas Water Well Contractor's License No. 134 This Water Well Record was completed on (mo/day/yr) 4-6-98 under the business name of Rosencrantz-Bemis by (signature) Freddie Hedson