

WATER WELL RECORD Form WWC-5

☒ Original Record ☐ Correction ☐ Change in Well Use

Division of Water
Resources App. No.

20180252

Well ID

1 LOCATION OF WATER WELL:

County: Stafford

Fraction

1/4 SE 1/4 SE 1/4 NE 1/4

Section Number
18

Township Number
T 25 S

Range Number
R 13 E W

2 WELL OWNER: Last Name: Long

Business:

Address: 991 NE 10th Ave.

Address:

City: St. John


State: KS

ZIP: 67576

First: Jerry

Street or Rural Address where well is located (if unknown, distance and direction from nearest town or intersection): If at owner's address, check here: ☐
8S, 2W of St. John, KS

3 LOCATE WELL WITH "X" IN SECTION BOX:

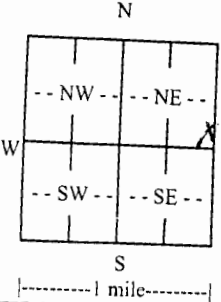

4 DEPTH OF COMPLETED WELL: 95 ft.

Depth(s) Groundwater Encountered: 1) 20 ft.

2) ft. 3) ft., or 4) ☐ Dry Well

WELL'S STATIC WATER LEVEL: 20 ft.

☒ below land surface, measured on (mo-day-yr).....

☐ above land surface, measured on (mo-day-yr).....

Pump test data: Well water was ft.

after..... hours pumping gpm

Well water was ft.

after..... hours pumping gpm

Estimated Yield: 80 gpm

Bore Hole Diameter: 8 in. to ft. and

..... in. to ft.

5 Latitude: (decimal degrees)

Longitude: (decimal degrees)

Horizontal Datum: ☐ WGS 84 ☐ NAD 83 ☐ NAD 27

Source for Latitude/Longitude:

☐ GPS (unit make/model:)

(WAAS enabled? ☐ Yes ☐ No)

☐ Land Survey ☐ Topographic Map

☐ Online Mapper:

6 Elevation: ft. ☐ Ground Level ☐ TOC

Source: ☐ Land Survey ☐ GPS ☐ Topographic Map

☐ Other

7 WELL WATER TO BE USED AS:

1. Domestic:

- ☐ Household
☐ Lawn & Garden
☐ Livestock

2. Irrigation

3. Feedlot

4. Industrial

5. ☐ Public Water Supply: well ID

6. ☐ Dewatering: how many wells?

7. ☐ Aquifer Recharge: well ID

8. ☐ Monitoring: well ID

9. Environmental Remediation: well ID

☐ Air Sparge ☐ Soil Vapor Extraction

☐ Recovery ☐ Injection

10. ☒ Oil Field Water Supply: lease Mary #1

11. Test Hole: well ID

☐ Cased ☐ Uncased ☐ Geotechnical

12. Geothermal: how many bores?

a) Closed Loop ☐ Horizontal ☐ Vertical

b) Open Loop ☐ Surface Discharge ☐ Inj. of Water

13. ☐ Other (specify):

Was a chemical/bacteriological sample submitted to KDHE? ☐ Yes ☒ No If yes, date sample was submitted:

Water well disinfected? ☒ Yes ☐ No

8 TYPE OF CASING USED: ☐ Steel ☒ PVC ☐ Other CASING JOINTS: ☒ Glued ☐ Clamped ☐ Welded ☐ Threaded

Casing diameter 5 in. to 75 ft., Diameter in. to ft., Diameter in. to ft.

Casing height above land surface 12 in. Weight 2.8 lbs./ft. Wall thickness or gauge No. Sch. 40

TYPE OF SCREEN OR PERFORATION MATERIAL:

- ☐ Steel ☐ Stainless Steel ☐ Fiberglass ☒ PVC ☐ Other (Specify)
- ☐ Brass ☐ Galvanized Steel ☐ Concrete tile ☐ None used (open hole)

SCREEN OR PERFORATION OPENINGS ARE:

- ☐ Continuous Slot ☐ Mill Slot ☐ Gauze Wrapped ☐ Torch Cut ☐ Drilled Holes ☐ Other (Specify)
- ☐ Louvered Shutter ☐ Key Punched ☐ Wire Wrapped ☒ Saw Cut ☐ None (Open Hole)

SCREEN-PERFORATED INTERVALS: From 75 ft. to 95 ft., From ft. to ft., From ft. to ft.

GRAVEL PACK INTERVALS: From 20 ft. to 95 ft., From ft. to ft., From ft. to ft.

GROUT MATERIAL: ☐ Neat cement ☐ Cement grout ☒ Bentonite ☐ Other

Grout Intervals: From 0 ft. to 20 ft., From ft. to ft., From ft. to ft.

NEAREST SOURCE OF POSSIBLE CONTAMINATION:

- ☐ Septic Tank ☐ Lateral Lines ☐ Pit Privy ☐ Livestock Pens ☐ Insecticide Storage
- ☐ Sewer Lines ☐ Cess Pool ☐ Sewage Lagoon ☐ Fuel Storage ☐ Abandoned Water Well
- ☐ Watertight Sewer Lines ☐ Seepage Pit ☐ Feedyard ☐ Fertilizer Storage ☒ Oil Well/Gas Well

Other (Specify) Distance from well? 130 ft.

Direction from well? South

FROM	TO	LITHOLOGIC LOG	FROM	TO	LITHO. LOG (cont.) or PLUGGING INTERVALS
	1	sandy top soil			
	50	sandy clay			Sterling Drilling Company
	95	sand and gravel			P O Box 1006
					Pratt, KS 67124

Notes:

Kgs Drl

CONTRACTOR'S OR LANDOWNER'S CERTIFICATION: This water well was ☒ constructed, ☐ reconstructed, or ☐ plugged under my jurisdiction and was completed on (mo-day-year) 10/23/18 and this record is true to the best of my knowledge and belief.

Kansas Water Well Contractor's License No. 186 This Water Well Record was completed on (mo-day-year) 10/28/18

Under the business name of Kelly's Water Well Service, Inc. Signature: K. Adams

Mail 1 white copy along with a fee of \$5.00 for each constructed well to: Kansas Department of Health and Environment, Bureau of Water, GWTS Section,



ASSIGNMENT OF WATER WELL TO LANDOWNER

I, Jerry Long of 991 NE 10th Avenue
(Landowner's address)

St. John, KS 67576 am the landowner on which a water well is located in
(City) (State)
the SW quarter of the SE quarter of the NE quarter in Section 18, Township 25s,
Range 13 E/W, in Stafford County, Kansas which is approximately
3125 feet north/south, and 705 feet east/west of the apparent SE section
corner. The water well was drilled in October 2018 (month/year).

I hereby request that Sterling Drilling/Thomas Garner Inc leave the water well,
(Operator name)

which was drilled by Temporary Water Permit # 20180252, unplugged, and I will
assume all responsibility for the plugging of said water well in accordance with the requirements
of the Kansas Department of Health and Environment regulation K.A.R. 28-30-7.

LANDOWNER:

Jerry E Long 11-28-18
(Signature) (Date)

Jerry E Long
(Print)

OPERATOR:

Gary M Talbott 11/12/18
(Signature) (Date)

By: **Gary M Talbott/Sterling Drilling**
(Agent)

IF ADDITIONAL LANDOWNER

(Signature) (Date)

(Print)