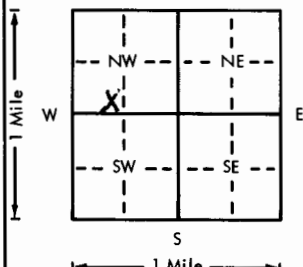


USE TYPEWRITER OR BALL
POINT PEN-PRESS FIRMLY,
PRINT CLEARLY.

WATER WELL RECORD
KSA 82a-1201-1215

Kansas Department of Health and
Environment-Division of Environment
(Water well Contractors)
Topeka, Kansas 66620

1. Location of well:		County Stafford	Fraction SE 1/4 SW 1/4 NW 1/4	Section number 2	Township number T 25 S	Range number R 13 E
2. Distance and direction from nearest town or city: 6 S, 1 E.		3. Owner of well: ALLEN DRILLING CO.		R.R. or street: Box 1389		
Street address of well location if in city: ST. JOHN, KS		City, state, zip code: Great Bend, KS				
4. Locate with "X" in section below:		Sketch map:		6. Bore hole dia. 7 in. Completion date 5-14-77		
				Well depth 100 ft.		
5. Type and color of material		From		To		7. Cable tool ☒ Rotary ☐ Driven ☐ Dug ☐ Hollow rod ☐ Jetted ☐ Bored ☐ Reverse rotary
Top Soil - Clay		0		60		8. Use: ☐ Domestic ☐ Public supply ☐ Industry ☐ Irrigation ☐ Air conditioning ☐ Stock ☐ Lawn ☒ Oil field water ☐ Other
Sand		60		75		9. Casing: Material ☐ Height: Above ☐ Below ☐ Threaded ☐ Welded ☐ Surface 12 in. RMP ☐ PVC ☒ Weight ☐ lbs./ft. Dia. 4 in. to 100 ft. depth Wall Thickness: inches or Dia. ☐ in. to ☐ ft. depth gage No. SC440
Sand - Gravel		75		100		10. Screen: Manufacturer's name Jet Stream Type PVC Dia. 4 Slot/gauze 1/16 Length 20' Set between 80 ft. and 100 ft. ft. and ft. Gravel pack? ☐ Size range of material
						11. Static water level: ☐ mo./day/yr. 20 ft. below land surface Date 5-14-77
						12. Pumping level below land surfaces: ft. after hrs. pumping g.p.m. ft. after hrs. pumping g.p.m. Estimated maximum yield 60 g.p.m.
						13. Water sample submitted: ☐ mo./day/yr. Yes ☒ No Date
						14. Well head completion: ☐ Pitless adapter 12 Inches above grade
						15. Well grouted? ☒ With: ☐ Neat cement ☒ Bentonite ☐ Concrete Depth: From 0 ft. to 10 ft.
						16. Nearest source of possible contamination: oil ft. 70 Direction SE Type TEST Well disinfected upon completion? ☐ Yes ☒ No
						17. Pump: ☒ Not installed Manufacturer's name Model number HP Volts Length of drop pipe ft. capacity g.p.m. Type: ☐ Submersible ☐ Turbine ☐ Jet ☐ Reciprocating ☐ Centrifugal ☐ Other
18. Elevation:		19. Remarks:		20. Water well contractor's certification: This well was drilled under my jurisdiction and this report is true to the best of my knowledge and belief. 1986 Kelly's Water Well Ser Business name License No. Address R2 Great Bend, KS Signed Kelly Price Date 8-20 Authorized representative		