

1 LOCATION OF WATER WELL	Fraction	Section Number	Township Number	Range Number
County: Stafford	NW 1/4 NW 1/4 NW 1/4	6	T 25 S	R 13 EW

Distance and direction from nearest town or city? **2 mi W, 6 mi S of St. John**

Street address of well if located within city?

2 WATER WELL OWNER: **KGS/GWMD#5**

RR#, St. Address, Box # :
 City, State, ZIP Code : **St. John, Kansas 67576**

Board of Agriculture, Division of Water Resources
 Application Number:

3 DEPTH OF COMPLETED WELL: **146** ft. Bore Hole Diameter: **8** in. to **146** ft., and ... in. to ... ft.

Well Water to be used as:

1 Domestic	3 Feedlot	5 Public water supply	8 Air conditioning	11 Injection well
2 Irrigation	4 Industrial	6 Oil field water supply	9 Dewatering	12 Other (Specify below)
		7 Lawn and garden only	10 Observation well	Research

Well's static water level: **13.2** ft. below land surface measured on **October** month **22** day **1982** year

Pump Test Data : Well water was ... ft. after ... hours pumping. ... gpm

Est. Yield gpm: Well water was ... ft. after ... hours pumping. ... gpm

4 TYPE OF BLANK CASING USED:

1 Steel	3 RMP (SR)	5 Wrought iron	8 Concrete tile	Casing Joints: Glued <input checked="" type="checkbox"/> Clamped
2 PVC	4 ABS	6 Asbestos-Cement	9 Other (specify below)	Welded
		7 Fiberglass		Threaded

Blank casing dia: **5** in. to **135** ft., Dia ... in. to ... ft., Dia ... in. to ... ft.

Casing height above land surface: **16** in., weight ... lbs./ft. Wall thickness or gauge No. **Schd 40**

TYPE OF SCREEN OR PERFORATION MATERIAL:

1 Steel	3 Stainless steel	5 Fiberglass	8 RMP (SR)	10 Asbestos-cement
2 Brass	4 Galvanized steel	6 Concrete tile	9 ABS	11 Other (specify)
				12 None used (open hole)

Screen or Perforation Openings Are:

1 Continuous slot	3 Mill slot	5 Gauzed wrapped	8 Saw cut	11 None (open hole)
2 Louvered shutter	4 Key punched	6 Wire wrapped	9 Drilled holes	
		7 Torch cut	10 Other (specify)	

Screen-Perforation Dia: **5** in. to **145** ft., Dia ... in. to ... ft., Dia ... in. to ... ft.

Screen-Perforated Intervals: From **135** ft. to **145** ft., From ... ft. to ... ft., From ... ft. to ... ft.

Gravel Pack Intervals: From **145** ft. to **133** ft., From ... ft. to ... ft., From ... ft. to ... ft.

5 GROUT MATERIAL: **1 Neat cement** 2 Cement grout 3 Bentonite 4 Other

Grouted Intervals: From **133** ft. to **80** ft., From **6** ft. to **1.5** ft., From ... ft. to ... ft.

What is the nearest source of possible contamination: **not determined**

1 Septic tank	4 Cess pool	7 Sewage lagoon	10 Fuel storage	14 Abandoned water well
2 Sewer lines	5 Seepage pit	8 Feed yard	11 Fertilizer storage	15 Oil well/Gas well
3 Lateral lines	6 Pit privy	9 Livestock pens	12 Insecticide storage	16 Other (specify below)
			13 Watertight sewer lines	

Direction from well ... How many feet ... ? Water Well Disinfected? Yes No

Was a chemical/bacteriological sample submitted to Department? Yes No If yes, date sample was submitted ... month ... day ... year: Pump Installed? Yes No

If Yes: Pump Manufacturer's name ... Model No. ... HP ... Volts

Depth of Pump Intake ... ft. Pumps Capacity rated at ... gal./min.

Type of pump: 1 Submersible 2 Turbine 3 Jet 4 Centrifugal 5 Reciprocating 6 Other

6 CONTRACTOR'S OR LANDOWNER'S CERTIFICATION: This water well was **1** constructed, (2) reconstructed, or (3) plugged under my jurisdiction and was completed on **July** month **26** day **1982** year

and this record is true to the best of my knowledge and belief. Kansas Water Well Contractor's License No. ...

This Water Well Record was completed on **Nov** month **15** day **82** year under the business name of **Patrick M Cobb** by (signature)

7 LOCATE WELL'S LOCATION WITH AN "X" IN SECTION BOX:

FROM	TO	LITHOLOGIC LOG	FROM	TO	LITHOLOGIC LOG
		see attached log			

ELEVATION:

Depth(s) Groundwater Encountered 1. ... ft. 2. ... ft. 3. ... ft. 4. ... ft. (Use a second sheet if needed)

INSTRUCTIONS: Use typewriter or ball point pen, please press firmly and PRINT clearly. Please fill in blanks, underline or circle the correct answers. Send top three copies to Kansas Department of Health and Environment, Division of Environment, Water Well Contractors, Topeka, KS 66620. Send one to WATER WELL OWNER and retain one for your records.

OFFICE USE ONLY

T

R

SEC.

1/4

1/4

1/4

BIG BEND GMD#5-KGS
WATER QUALITY
OBSERVATION WELL
NETWORK

SITE NUMBER : 6
SITE LOCATION: NW SW NW
SAMPLING DATE: OCTOBER 1978


LEGAL LOCATION : 6-25-13W
COUNTY : STAFFORD
NUMBER OF WELLS: 3

WATER QUALITY ANALYSIS (mg./l)


	<u>WELL#1</u>	<u>WELL#2</u>	<u>WELL#3</u>	<u>WELL#4</u>
TEMPERATURE, C	<u>16.1</u>	<u>17.0</u>	<u>15.8</u>	<u> </u>
SPECIFIC CONDUCTANCE umho @ 25 deg C.	<u>84,100</u>	<u>5010</u>	<u>695</u>	<u> </u>
pH	<u>9.5</u>	<u>7.4</u>	<u>7.8</u>	<u> </u>
CALCIUM (Ca):	<u>1810</u>	<u>152</u>	<u>43</u>	<u> </u>
MAGNESIUM (Mg):	<u>550</u>	<u>31</u>	<u>5.2</u>	<u> </u>
POTASSIUM (K):	<u>80</u>	<u>5.1</u>	<u>2.7</u>	<u> </u>
SILICA (SiO ₂):	<u>37</u>	<u>23</u>	<u>20</u>	<u> </u>
SODIUM (Na):	<u>25,000</u>	<u>940</u>	<u>96</u>	<u> </u>
SAR:	<u>130</u>	<u>18</u>	<u>3.7</u>	<u> </u>
BICARBONATE (HCO ₃):	<u>-</u>	<u>197</u>	<u>195</u>	<u> </u>
CHLORIDE (Cl):	<u>40,000</u>	<u>1661</u>	<u>99</u>	<u> </u>
FLUORIDE (F):	<u>0.1</u>	<u>0.4</u>	<u>0.6</u>	<u> </u>
NITRATE (NO ₃):	<u>1.3</u>	<u>7.5</u>	<u>19</u>	<u> </u>
ORTHO-PHOSPHATE (PO ₄):	<u>0.14</u>	<u>0.21</u>	<u>0.13</u>	<u> </u>
SULFATE (SO ₄):	<u>5134</u>	<u>165</u>	<u>23</u>	<u> </u>
SULFIDE (S):	<u> </u>	<u> </u>	<u> </u>	<u> </u>
STRONTIUM (Sr):	<u>33</u>	<u>1.4</u>	<u>0.3</u>	<u> </u>

SITE NUMBER : 6
SITE LOCATION : NW SW NW
LEGAL LOCATION: SEC6 T25S R13W
COUNTY : STAFFORD

LANDOWNER: BILL McCANDLESS
ADDRESS : ROUTE 1
St. JOHN, KANSAS 67576
PHONE NO.: 316-549-3356

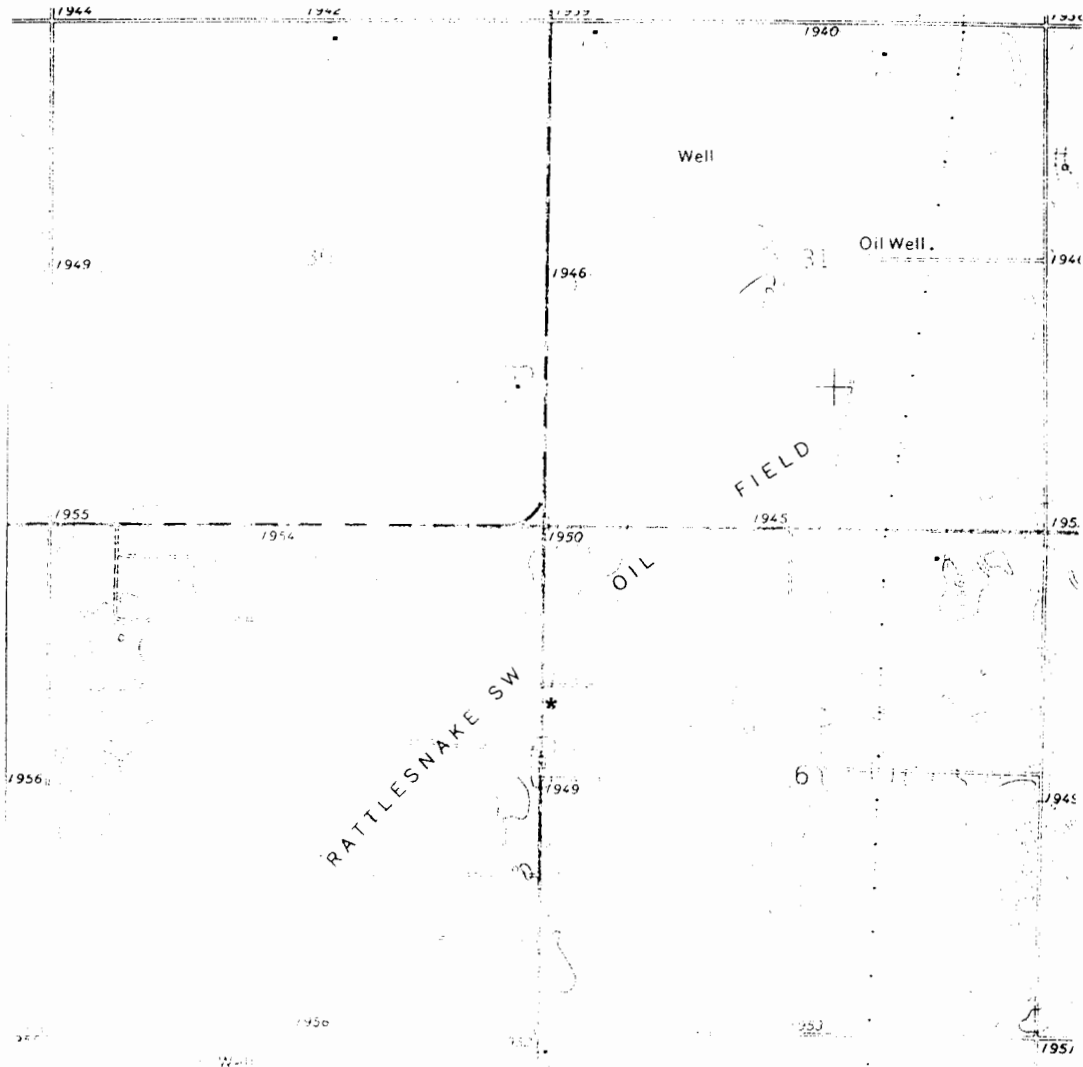


WELL LOCATION *

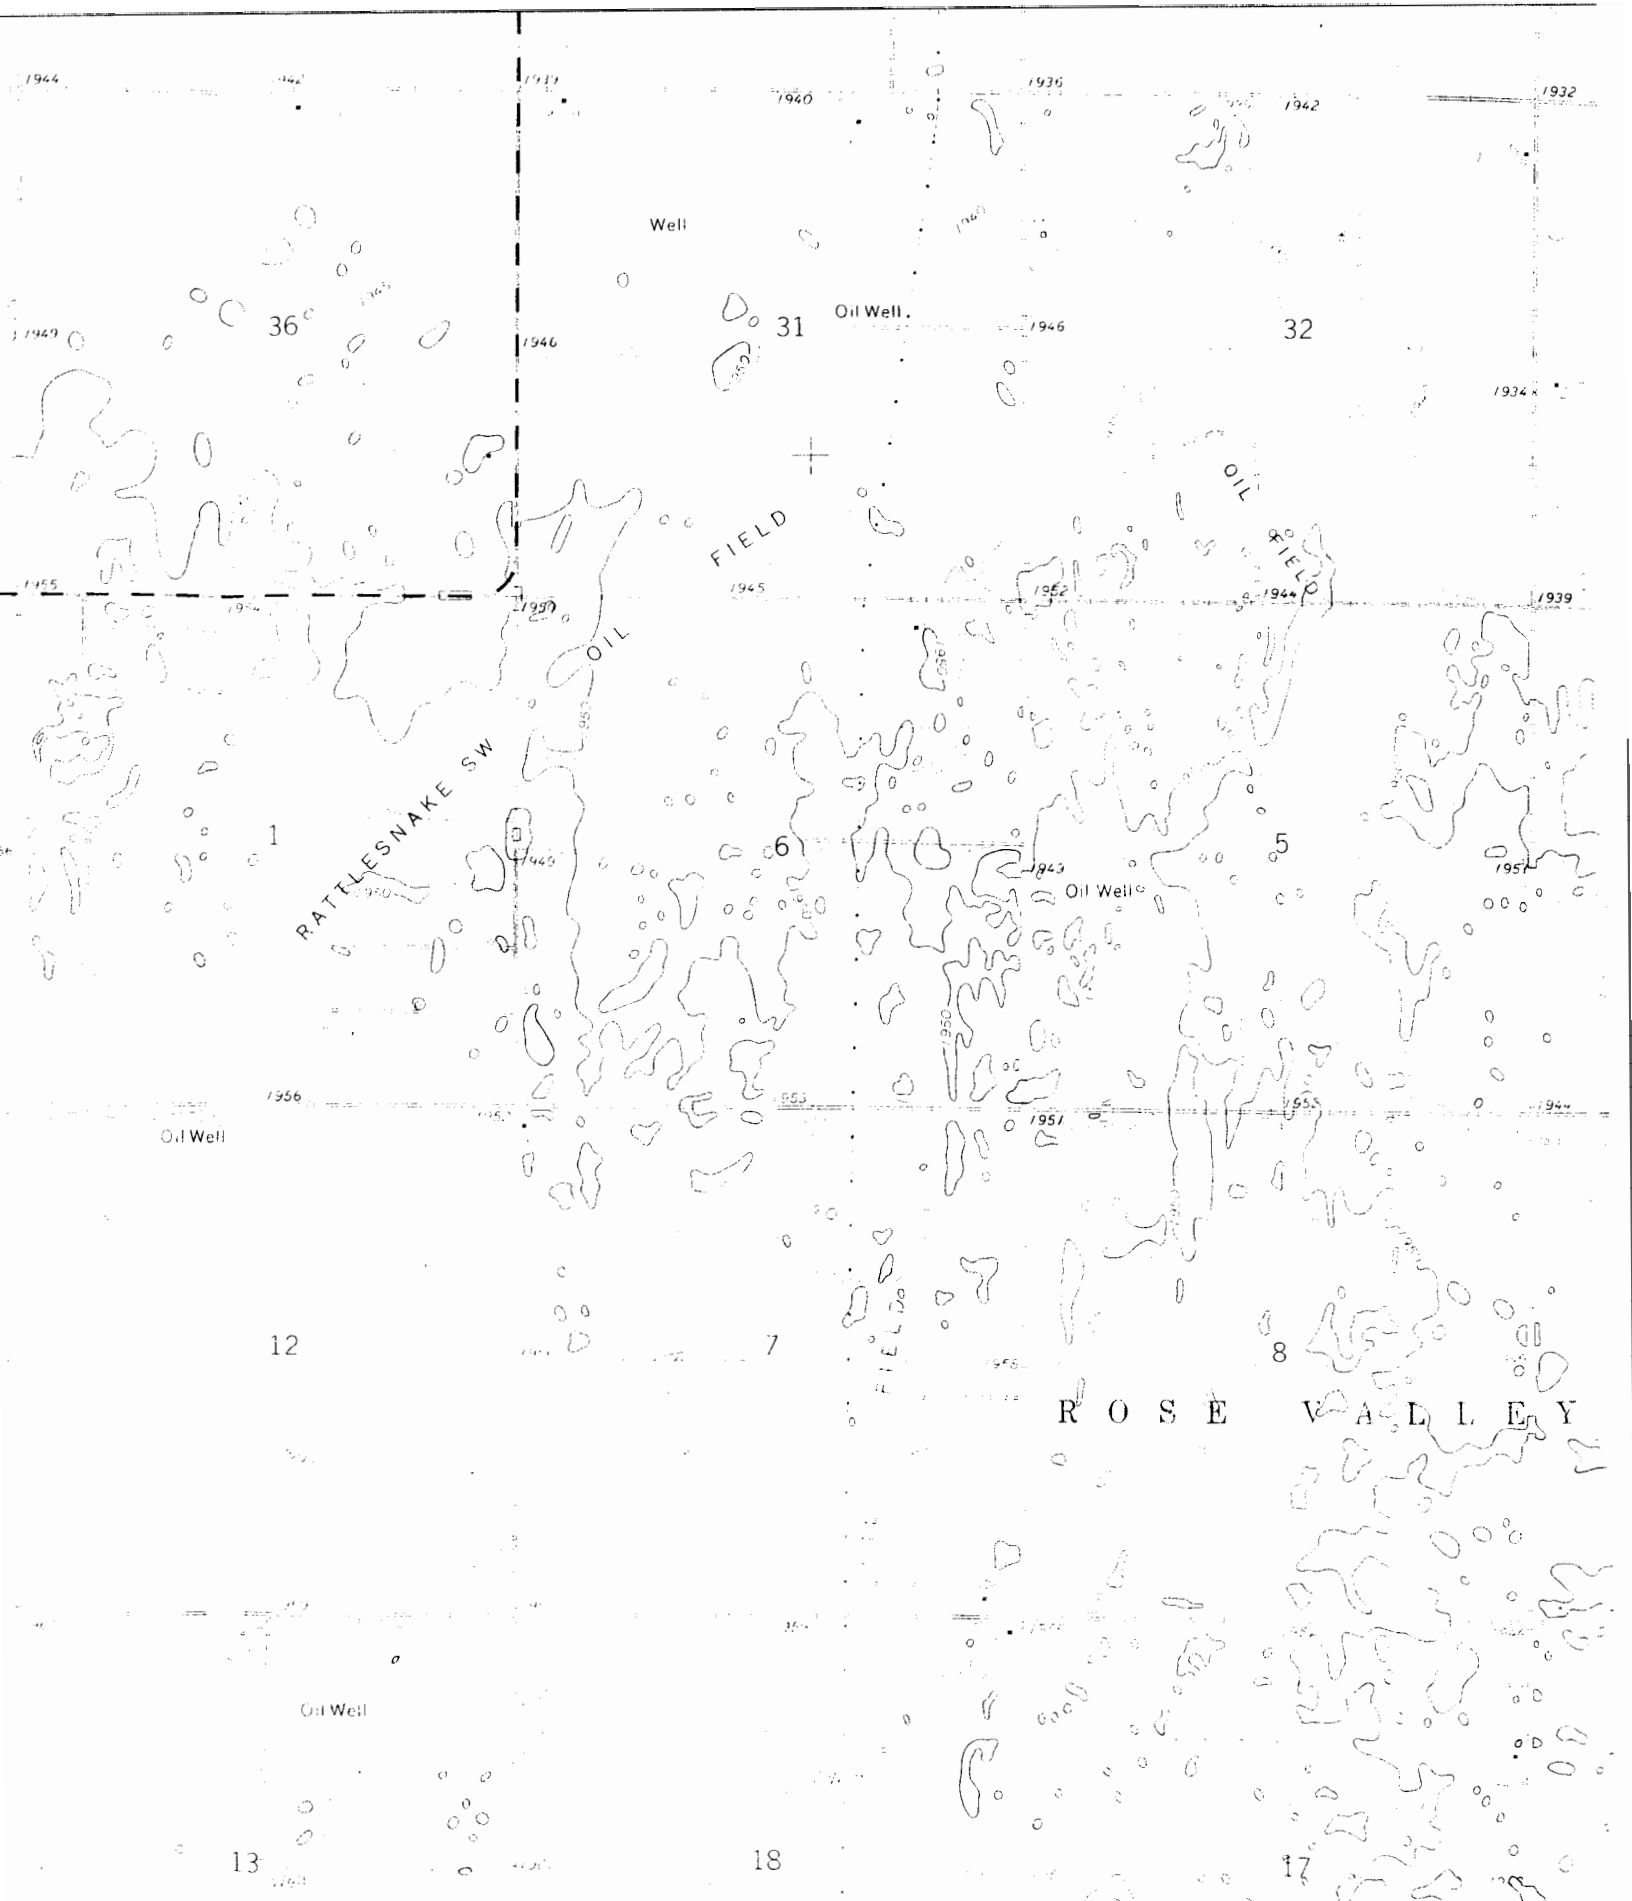

516 (BYERS) 517 R. 14 W R 13 W 518 47'30" 519 520 NORTH GEOLOGICAL SURVEY

SCALE 1:24,000

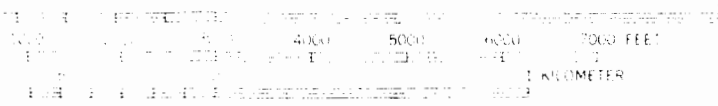

ROAD CLASSIFICATION
 Primary highway hard surface
 Secondary highway hard surface