


USE TYPEWRITER OR BALL POINT PEN-PRESS FIRMLY, PRINT CLEARLY.

WATER WELL RECORD
KSA 82a-1201-1215

Kansas Department of Health and Environment-Division of Environment (Water well Contractors)
Topeka, Kansas 66620

1. Location of well: County **STAFFORD** Fraction **NE 1/4 NE 1/4 NW 1/4** Section number **7** Township number **T 25 S R 13 W E/W** Range number

2. Distance and direction from nearest town or city: **75 ft 2 1/2 W OF ST JOHN**
Street address of well location if in city:
3. Owner of well: **WAYNE BROOKS**
R.R. or street:
City, state, zip code: **MACK'SVILLE, KS**

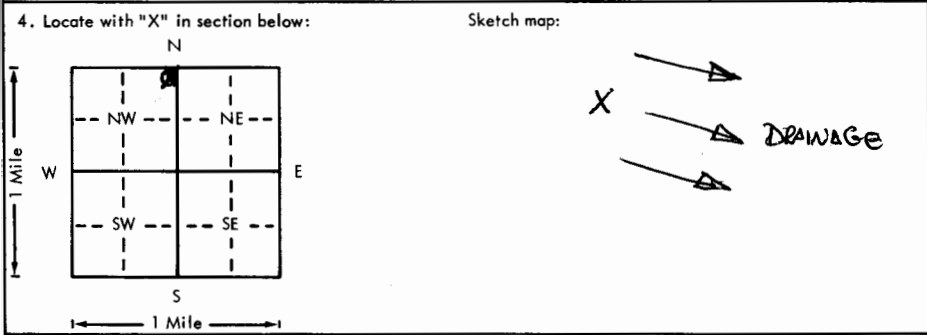

6. Bore hole dia. **10** in. Completion date **9-JULY-79**
Well depth **84** ft.
7. Cable tool Rotary Driven Dug
 Hollow rod Jetted Bored Reverse rotary
8. Use: Domestic Public supply Industry
 Irrigation Air conditioning Stock
 Lawn Oil field water Other
9. Casing: Material _____ Height: **Above** or below
Threaded _____ Welded _____ Surface **12** in.
RMP PVC _____ Weight _____ lbs./ft.
Dia. **5** in. to **84** ft. depth Wall Thickness: inches or
Dia. _____ in. to _____ ft. depth gage No. **200**

5. Type and color of material	From	To
SOIL, SANDY	0	2
SAND, FINE	2	21
CLAY, SOY GRAY	21	25
SAND, FINE	25	31
CLAY, SOY GRAY	31	32
SAND, FINE TO MED	32	39
CLAY, SOY GRAY	39	51
CLAY, YELLOW GRAY	51	60
SAND & GRAVEL, MED TO COARSE - LOOSE	60	83
CLAY, TAN W/ SAND STREAKS	83	95
CLAY, WHITE & BROWN	95	105
WATER SAMPLE WE CHECKED.		
HARDNESS 11 GR.		
CHLORIDES 75 PPM (Use a second sheet if needed)		

10. Screen, Manufacturer's name **JAL**
Type **RMP** Dia. **5"**
Slot/gauze **1/8" sawed** Length **20'**
Set between **64** ft. and **84** ft.
ft. and _____ ft.
Gravel pack? **YES** Size range of material **1/4" x 1/2"**
11. Static water level: _____ mo./day/yr.
23 ft. below land surface Date **9 JULY 79**
12. Pumping level below land surfaces:
_____ ft. after _____ hrs. pumping _____ g.p.m.
_____ ft. after _____ hrs. pumping _____ g.p.m.
Estimated maximum yield **50** g.p.m.
13. Water sample submitted: _____ mo./day/yr.
Yes No Date _____
14. Well head completion:
 Pitless adapter **12** Inches above grade
15. Well grouted? **YES**
With: Neat cement Bentonite _____ Concrete
Depth: From **4** ft. to **14** ft.
16. Nearest source of possible contamination:
ft. _____ Direction _____ Type **NONE**
Well disinfected upon completion? Yes _____ No
17. Pump: Not installed
Manufacturer's name _____
Model number _____ HP _____ Volts _____
Length of drop pipe _____ ft. capacity _____ g.p.m.
Type:
____ Submersible _____ Turbine
____ Jet _____ Reciprocating
____ Centrifugal _____ Other

18. Elevation:
Topography:
____ Hill
____ Slope
 Upland
____ Valley
19. Remarks:
4'x4'x4" CONCRETE BELOW PIT ADAPTER

20. Water well contractor's certification:
This well was drilled under my jurisdiction and this report is true to the best of my knowledge and belief.
CENTRAL Well & Pump 325
Business name _____ License No. _____
Address **121 S. TAYLOR PIKE**
Signed **W. Honovich** Date **12 July 79**
Authorized representative

T 25 S R 13 W E/W