

1 LOCATION OF WATER WELL:		Fraction		Section Number		Township Number		Range Number	
County:	Stafford	SE ¼	SE ¼	NE ¼	7	T	25	S	R 13W E/W

Distance and direction from nearest town or city street address of well if located within city?

2 W, 7½ S of St. John, Kansas

2 WATER WELL OWNER: Ronald T. Curtis Estate

RR#, St. Address, Box # : c/o Rodney Lyons


Board of Agriculture, Division of Water Resources

City, State, ZIP Code : St. John, Kansas 67576

Application Number: _____

3 LOCATE WELL'S LOCATION WITH AN "X" IN SECTION BOX:

4 DEPTH OF COMPLETED WELL... 80 ft. ELEVATION: ... Unknown

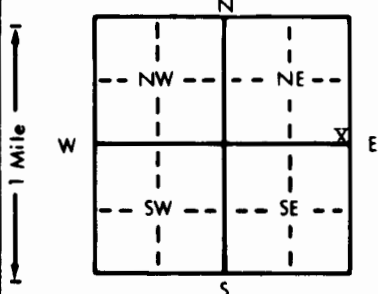

Depth(s) Groundwater Encountered 1. 38 ft. 2. ft. 3. ft.

WELL'S STATIC WATER LEVEL 38 . ft. below land surface measured on mo/day/yr 5/20/92

Pump test data: Well water was ft. after hours pumping gpm

Est. Yield . . . 60 . . . gpm: Well water was ft. after hours pumping gpm

Bore Hole Diameter . . . 8 in. to 80 ft., and in. to ft.

WELL WATER TO BE USED AS:	5 Public water supply	8 Air conditioning	11 Injection well
---------------------------	-----------------------	--------------------	-------------------

1 Domestic	3 Feedlot	6 Oil field water supply	9 Dewatering	12 Other (Specify below)
------------	-----------	--------------------------	--------------	--------------------------


Was a chemical/bacteriological sample submitted to Department? Yes.....No.....; If yes, mo/day/yr sample was submitted

Water Well Disinfected? Yes.....No.....

5 TYPE OF BLANK CASING USED:

5 Wrought iron	8 Concrete tile	CASING JOINTS: Glued	Clamped
----------------	-----------------	----------------------	---------

1 Steel	3 RMP (SR)	6 Asbestos-Cement	9 Other (specify below)	Welded
---------	------------	-------------------	-------------------------	--------

2 PVC 4 ABS 7 Fiberglass Threaded.....

Maximum casing diameter 5 in. to 60 ft., Dia in. to ft., Dia in. to ft.

Casing height above land surface 12 in., weight 2.8 lbs./ft. Wall thickness or gauge No. Sch. 40

TYPE OF SCREEN OR PERFORATION MATERIAL:

1 Steel 3 Stainless steel 5 Fiberglass 8 RMP (SR) 11 Other (specify)

2 Brass 4 Galvanized steel 6 Concrete tile 9 ABS 12 None used (open hole)

SCREEN OR PERFORATION OPENINGS ARE

1 Continuous slot	3 Mill slot	6 Wire wrapped	9 Drilled holes
-------------------	-------------	----------------	-----------------

2 Louvered shutter 4 Key punched 7 Torch cut 10 Other (specify)

SCREEN-PERFORATED INTERVALS: From 60 ft. to .. 80 ft., From ft. to ft.

From ft. to ft., From ft. to ft.

GRAVEL PACK INTERVALS: From.....20.....ft. to .. 80.....ft., From.....ft. to.....ft.

From	ft. to	ft., From	ft. to	ft.

6) GROUT MATERIAL:		1 Neat cement	2 Cement grout	3 Bentonite	4 Other
Grout Interval:	From	0	# to 30	# to	# to

What is the nearest source of possible contamination: 10. Livestock pens 14. Abandoned water well

1 Sepsic tank	4 Lateral lines	7 Pit privy	10 Livestock pens	14 Abandoned water well
2 Septic tank	5 Lateral lines	8 Pit privy	11 Fuel storage	15 Oil well/Gas well

1 Septic tank	4 Lateral lines	7 Pit privy	11 Fuel storage	15 Oil well/gas well
2 Sewer lines	5 Cess pool	8 Sewage lagoon	12 Fertilizer storage	16 Other (specify below)

3 Watertight sewer lines	6 Seepage pit	9 Feedyard	13 Insecticide storage	In pasture

Direction from well? _____ How many feet? _____

FROM	TO	LITHOLOGIC LOG	FROM	TO	PLUGGING INTERVALS
------	----	----------------	------	----	--------------------

[illegible]

7 CONTRACTOR'S OR LANDOWNER'S CERTIFICATION: This water well was (1) constructed, (2) reconstructed, or (3) plugged under my jurisdiction and was

completed on (mo/day/year) 5/20/92 and this record is true to the best of my knowledge and belief. Kansas

Water Well Contractor's License No. 186 This Water Well Record was completed on (mo/day/yr) 6/17/92

for the business name of Kelly's Water Well Service by (signature) [Signature]

INSTRUCTIONS: Use typewriter or ball point pen. PLEASE PRESS FIRMLY and PRINT clearly. Please fill in blanks, underline or circle the correct answers. Send top three copies to Kansas Department of Health and Environment, Bureau of Water, Topeka, Kansas 66620-0001. Telephone: 813-286-5545. Send one to WATER WELL OWNER and retain one for your records.