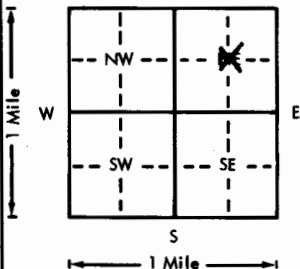


USE TYPEWRITER OR BALL
POINT PEN-PRESS FIRMLY,
PRINT CLEARLY.

WATER WELL RECORD
KSA 82a-1201-1215

Kansas Department of Health and
Environment-Division of Environment
(Water well Contractors)
Topeka, Kansas 66620

1. Location of well:		County Stafford	Fraction NE 1/4 C 1/4 NE 1/4	Section number 10	Township number T 25 S	Range number R 13 E
2. Distance and direction from nearest town or city: 7 miles South & 1 East of St. John Street address of well location if in city:				3. Owner of well: Vernon Fox R.R. or street: St. John, Kansas City, state, zip code:		
4. Locate with "X" in section below:  Sketch map: Well No. 1 (TH 1-76)				6. Bore hole dia. 30 in. Completion date Well depth 103 ft. 7/19/76		
5. Type and color of material				From	To	7. <input type="checkbox"/> Cable tool <input type="checkbox"/> Rotary <input type="checkbox"/> Driven <input type="checkbox"/> Dug <input type="checkbox"/> Hollow rod <input type="checkbox"/> Jetted <input checked="" type="checkbox"/> Bored <input checked="" type="checkbox"/> Reverse rotary
Fill dirt				0	3	8. Use: <input type="checkbox"/> Domestic <input type="checkbox"/> Public supply <input type="checkbox"/> Industry <input checked="" type="checkbox"/> Irrigation <input type="checkbox"/> Air conditioning <input type="checkbox"/> Stock <input type="checkbox"/> Lawn <input type="checkbox"/> Oil field water <input type="checkbox"/> Other
Sandy soil				3	5	9. Casing: Material Stl Height: Above or below Threaded <input type="checkbox"/> Welded <input checked="" type="checkbox"/> Surface 12 in. RMP <input type="checkbox"/> PVC <input type="checkbox"/> Weight 36.91 lbs./ft. Dia 16 in. to 67 ft. depth Wall Thickness: inches or Dia. <input type="checkbox"/> in. to <input type="checkbox"/> ft. depth Gauge No. 219
Brown & gray clay w/sand & gravel				5	38	10. Screen: Manufacturer's name Doerr Metal Products Type Stl Dia. 16 " Slot/gauze 1/8 " Length 36 ' Set between 67 ft. and 103 ft. Gravel pack? yes Size range of material 1/8 x 3/8
Med. to co. sand & gravel				38	52	11. Static water level: 14 ft. below land surface Date 6/22/76
Brown & gray clay w/sand lense				52	67	12. Pumping level below land surfaces: 35 ft. after 2.5 hrs. pumping 900 g.p.m. <input type="checkbox"/> ft. after <input type="checkbox"/> hrs. pumping <input type="checkbox"/> g.p.m. Estimated maximum yield 1000 g.p.m.
Med. to co. sand & gravel				67	103	13. Water sample submitted: Yes <input checked="" type="checkbox"/> No <input type="checkbox"/> Date <input type="checkbox"/>
						14. Well head completion: <input type="checkbox"/> Pitless adapter 12 Inches above grade
						15. Well grouted? yes With: <input type="checkbox"/> Neat cement <input type="checkbox"/> Bentonite <input checked="" type="checkbox"/> Concrete Depth: From 0 ft. to 10 ft.
						16. Nearest source of possible contamination: ft. 2500 Direction West Type Farm Well disinfected upon completion? <input type="checkbox"/> Yes <input checked="" type="checkbox"/> No
						17. Pump: Manufacturer's name Layne & Bowler Model number 77157W HP 75 Volts <input type="checkbox"/> Length of drop pipe 60 ft. capacity 900 g.p.m. Type: <input type="checkbox"/> Submersible <input checked="" type="checkbox"/> Turbine <input type="checkbox"/> Jet <input type="checkbox"/> Reciprocating <input type="checkbox"/> Centrifugal <input type="checkbox"/> Other
(Use a second sheet if needed)						
18. Elevation:		19. Remarks:				
Topography: <input type="checkbox"/> Hill <input checked="" type="checkbox"/> Slope <input checked="" type="checkbox"/> Upland <input type="checkbox"/> Valley		20. Water well contractor's certification: This well was drilled under my jurisdiction and this report is true to the best of my knowledge and belief. Layne Western Co. 102 Business name License No. Address Wichita, Kansas Signed [Signature] Date 7/30/76 Authorized representative				