


USE TYPEWRITER OR BALL POINT PEN-PRESS FIRMLY, PRINT CLEARLY.

WATER WELL RECORD
KSA 82a-1201-1215

Kansas Department of Health and Environment-Division of Environment
(Water well Contractors)
Topeka, Kansas 66620

1. Location of well: County **Stafford** Fraction **1/4 1/4 CSW 1/4** Section number **13** Township number **T 25 S R 13** Range number **13** (EW)

2. Distance and direction from nearest town or city: **10 1/2 miles Southeast of St. John, KS**
Street address of well location if in city:
3. Owner of well: **Mike & Tony Horstman**
c/o **Morris Garvin**
R.R. or street: **102 S. Main**
City, state, zip code: **St. John, KS 67576**

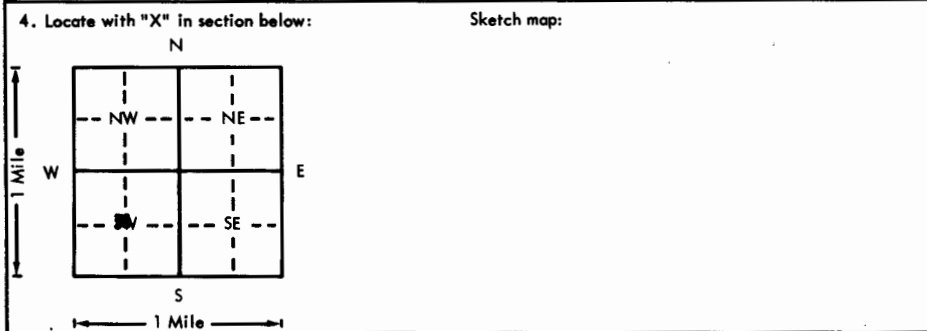

6. Bore hole dia. **24** in. Completion date **8-20-76**
Well depth **115** ft.
7. Cable tool Rotary Driven Dug
 Hollow rod Jetted Bored Reverse rotary
8. Use: Domestic Public supply Industry
 Irrigation Air conditioning Stock
 Lawn Oil field water Other
9. Casing: Material **steel** Height: (Above or below) **12** in.
Threaded Welded Surface **12** in.
RMP PVC Weight **30.3** lbs./ft.
Dia. **16** in. to **45** ft. depth Wall Thickness: inches or
Dia. **16** in. to **95** ft. depth gage No. **7ga.**

5. Type and color of material	From	To
top soil	0	3
sand clay & sand & sandstone streaks	3	20
brown & gray clay & limestone	20	41
sand & gravel	41	57
sand & gravel & clay streaks	57	60
brown & gray clay & limestone	60	93
sand & gravel & clay streaks	93	114
sand & gravel	114	115
(Use a second sheet if needed)		

10. Screen: Manufacturer's name **Doerr**
Type **Double-slot** Dia. **16"**
Slot gauge **1/8"** Length **40'**
Set between **45** ft. and **65** ft.
95 ft. and **115** ft.
Gravel pack? **yes** Size range of material **3/8-200**
11. Static water level: **17** ft. below land surface Date **8-18-76** mo./day/yr.
12. Pumping level below land surfaces: **N/C**
ft. after ___ hrs. pumping ___ g.p.m.
ft. after ___ hrs. pumping ___ g.p.m.
Estimated maximum yield ___ g.p.m.
13. Water sample submitted: ___ mo./day/yr.
Yes No Date ___
14. Well head completion: ___ Pitless adapter **12** inches above grade
15. Well grouted? **yes**
With: Neat cement ___ Bentonite ___ Concrete ___
Depth: From **0** ft. to **10** ft.
16. Nearest source of possible contamination: **NONE KNOWN**
ft. ___ Direction ___ Type ___
Well disinfected upon completion? ___ Yes No ___
17. Pump: ___ Not installed
Manufacturer's name **FMC Corp/ Peerless**
Model number **12LB-3** HP **80** Volts **---**
Length of drop pipe **70** ft. capacity **900** g.p.m.
Type: ___ Submersible Turbine ___ Reciprocating ___ Other ___
Centrifugal ___

18. Elevation: Topography: ___ Hill ___ Slope ___ Upland ___ Valley

19. Remarks:

20. Water well contractor's certification:
This well was drilled under my jurisdiction and this report is true to the best of my knowledge and belief.
Clarke Well & Equip. Inc. 185
Business name License No. **---**
Address **Great Bend, KS 67530**
Signed **D. W. Clark** Date **8-24-76**
Authorized representative

25
 13
 13
 CSW
 1/4
 1/4
 9/4