

1 LOCATION OF WATER WELL:	Fraction	Section Number	Township Number	Range Number
County: STAFFORD	SE ¼ SE ¼ SE ¼	14	T 25 S	R 13 E/W

Distance and direction from nearest town or city street address of well if located within city?


9-S 2-F OF ST. JOHN, KS.

2	WATER WELL OWNER:	RUTH RUSSELL
	RR#, St. Address, Box # :	RT.1 BOX 101
	City, State, ZIP Code :	ST. JOHN, KS. 67576

Board of Agriculture, Division of Water Resources
Application Number: _____

3 LOCATE WELL'S LOCATION WITH AN "X" IN SECTION BOX:

4 DEPTH OF COMPLETED WELL.....60..... ft. ELEVATION:

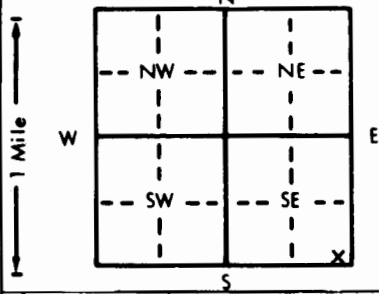

Depth(s) Groundwater Encountered 1. ft. 2. ft. 3. ft.
WELL'S STATIC WATER LEVEL 22 ft. below land surface measured on mo/day/yr

Pump test data:	Well water was	ft. after	hours pumping	gpm
Est. Yield	gpm: Well water was	ft. after	hours pumping	gpm

Bore Hole Diameter 9 in. to ft., and in. to ft.
WELL WATER TO BE USED AS: 5 Public water supply 8 Air conditioning 11 Injection well

* Domestic	3 Feedlot	6 Oil field water supply	9 Dewatering	12 Other (Specify below)
2 Irrigation	4 Industrial	7 Lawn and garden only	10 Monitoring well	

Was a chemical/bacteriological sample submitted to Department? Yes.....No.....X.....; If yes, mo/day/yr sample was submitted

Water Well Disinfected? Yes X No

5	TYPE OF BLANK CASING USED:	5 Wrought iron	8 Concrete tile	CASING JOINTS: Glued . ☒ . . . Clamped
---	----------------------------	----------------	-----------------	--

1 Steel	3 RMP (SR)	6 Asbestos-Cement	9 Other (specify below)	Welded
2 PVC	4 ABS	7 Fiberglass		Threaded

Blank casing diameter . . . 5 . . . in. to . . . 50 . . . ft., Dia . . . in. to . . . ft., Dia . . . in. to . . . ft.
Casing height above land surface . . . 24 . . . in. weight . . . lbs./ft. Wall thickness or gauge No. . . .

TYPE OF SCREEN OR PERFORATION MATERIAL:


1 Steel	3 Stainless steel	5 Fiberglass	7 MIM (etc.)	9 None (open hole)
2 Brass	4 Galvanized steel	6 Concrete tile	8 ABS	10 None used (open hole)
SCREEN OR PERFORATION OPENINGS ARE:				
		5 Gauzed wrapped	8 Saw cut	11 None (open hole)

1 Continuous slot	3 Mill slot	5 Glued wrapped	7 Saw cut	9 Holes (open hole)
2 Lowered shutter	4 Key punched	6 Wire wrapped	8 Drilled holes	10 Other (specify)
3 Torch cut				

SCREEN-PERFORATED INTERVALS: From 50 ft. to 60 ft. From ft. to ft.

GRAVEL PACK INTERVALS: From . . . **23** . . . ft. to . . . **60** . . . ft. From . . . ft. to . . . ft.

		From	ft. to	ft., From	ft. to	ft.
6	GROUT MATERIAL:	1 Neat cement	2 Cement grout	x ³ Bentonite	4 Other	

Grout intervals: From 3 ft to 23 ft., From _____ ft. to _____ ft., From _____ ft. to _____ ft.
What is the nearest source of possible contamination: 10 Livestock pens 14 Abandoned water well

1 Septic tank	4 Lateral lines	7 Pit privy	11 Fuel storage	15 Oil well/Gas well
2 Sewer lines	5 Cess pool	8 Sewage lagoon	12 Fertilizer storage	16 Other (specify below)

3 Watertight sewer lines	6 Seepage pit	9 Feedyard	13 Insecticide storage	None
Direction from well?			How many feet?	

[illegible]

7 CONTRACTOR'S OR LANDOWNER'S CERTIFICATION: This water well was (x) constructed, (2) reconstructed, or (3) plugged under my jurisdiction and was completed on (mo/day/year) 1-19-91 and this record is true to the best of my knowledge and belief. Kansas

Water Well Contractor's License No. 462-B This Water Well Record was completed on (mo/day/yr) 7-29-91
under the business name of SAM'S WATER WELL SERVICE by (signature) [Signature]