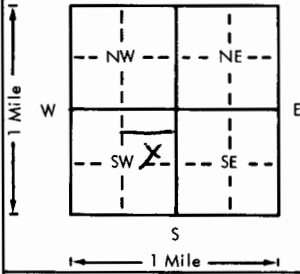


USE TYPEWRITER OR BALL
POINT PEN-PRESS FIRMLY,
PRINT CLEARLY.

WATER WELL RECORD
KSA 82a-1201-1215

Kansas Department of Health and
Environment-Division of Environment
(Water well Contractors)
Topeka, Kansas 66620

1. Location of well:		County STAFFORD	Fraction E 1/2 NE SW 1/4 1/4	Section number 29	Township number T 25	Range number S 13 W E/W
2. Distance and direction from nearest town or city: 10 miles South of 1/2 west			3. Owner of well: Duke Drig CO R.R. or street: City, state, zip code: Great Bend, Ks 67530			
4. Locate with "X" in section below:		Sketch map:		6. Bore hole dia. 9 in. Completion date 9-18-78 Well depth 80 ft.		
				7. Cable tool ☒ Rotary ☐ Driven ☐ Dug ☐ Hollow rod ☐ Jetted ☐ Bored ☐ Reverse rotary		
5. Type and color of material		From	To	8. Use: ☐ Domestic ☐ Public supply ☐ Industry ☐ Irrigation ☐ Air conditioning ☐ Stock ☐ Lawn ☒ Oil field water ☐ Other		
Fine sand		0	18	9. Casing: Material ☐ Height: Above or below Threaded ☐ Welded ☒ Surface 12 in. RMP ☐ PVC ☒ Weight 278-3 lbs./ft. Dia 5 in. to 80 ft. depth Wall Thickness: inches or Dia. in. to ft. depth gage No. 200, 265		
CLAY		18	30	10. Screen: Manufacturer's name Peerless Mfg Type Saw Dia. 5 Slot gauge 18 Length 20 Set between 80 ft. and 60 ft. ft. and ft.		
Fine Sand		30	60	Gravel pack? yes Size range of material 1/4-1/2		
Gravel		60	80	11. Static water level: 24 ft. below land surface Date 9-18-78 mo./day/yr.		
				12. Pumping level below land surfaces: ft. after hrs. pumping g.p.m. ft. after hrs. pumping g.p.m. Estimated maximum yield g.p.m.		
				13. Water sample submitted: X No Date Yes No		
				14. Well head completion: Pitless adapter 12 inches above grade		
				15. Well grouted? yes With: ☒ Neat cement ☒ Bentonite ☐ Concrete Depth: From 0 ft. to 10 ft.		
				16. Nearest source of possible contamination: None ft. Direction Type Well disinfected upon completion? ☒ Yes ☐ No		
				17. Pump: ☒ Not installed Manufacturer's name Model number HP Volts Length of drop pipe ft. capacity g.p.m. Type: ☐ Submersible ☐ Turbine ☐ Jet ☐ Reciprocating ☐ Centrifugal ☐ Other		
18. Elevation:		19. Remarks:		20. Water well contractor's certification: This well was drilled under my jurisdiction and this report is true to the best of my knowledge and belief. Myers Water Well 143 Business name License No. Address Great Bend Ks Signed Floyd Rosenbobl Date 9-18-78 Authorized representative		

25 130 W 29 CS NESW
1/4 1/4