USE TYPEWRITER OR BALL POINT PEN-PRESS FIRMLY, PRINT CLEARLY.

WATER WELL RECORD
KSA 82a-1201-1215

Kansas Department of Health and Environment-Division of Environment
(Water well Contractors)
Topeka, Kansas 66620

1. Location of well:	County	Fraction	Section number	Township number	Range number
	X Stafford	1/4 1/4 CSW 1/4	35	T 25 S	R 13 E (W)

2. Distance and direction from nearest town or city:
12½ mi. Southeast of St. John, KS
Street address of well location if in city:

3. Owner of well: Reggie Harrison
R.R. or street: (?)
City, state, zip code: St. John, KS 67576

4. Locate with "X" in section below: Sketch map:

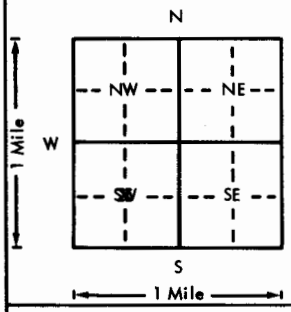

6. Bore hole dia. 24 in. Completion date 5-10-76
Well depth 85 ft.

7. __ Cable tool __ Rotary __ Driven __ Dug
__ Hollow rod __ Jetted __ Bored X Reverse rotary

8. Use: __ Domestic __ Public supply __ Industry
X Irrigation __ Air conditioning __ Stock
__ Lawn __ Oil field water __ Other

9. Casing: Material Steel Height: (Above) or below
Threaded __ Welded X Surface 12 in.
RMP __ PVC __ Weight 30.3 lbs./ft.
Dia 16 in. to 45 ft. depth Wall Thickness: inches or
Dia. __ in. to __ ft. depth gage No. 7 ga.

5. Type and color of material	From	To
Sandy top soil	0	5
Brown & gray clay	5	27
Sand & sandy clay	27	33
Sand, gravel & cemented streak at 75'	33	83
Brown clay	83	85

(Use a second sheet if needed)

10. Screen: Manufacturer's name Doerr
Type Double-slot Dia. 16"
Slot/gauze 1/8 Length 40'
Set between 45 ft. and 85 ft.
ft. and ft.
Gravel pack? Yes Size range of material 3/8-200

11. Static water level: mo./day/yr.
15 ft. below land surface Date 4-27-76

12. Pumping level below land surfaces: N/C
ft. after hrs. pumping g.p.m.
ft. after hrs. pumping g.p.m.
Estimated maximum yield g.p.m.

13. Water sample submitted: mo./day/yr.
__ Yes X No Date

14. Well head completion:
__ Pitless adapter 12 Inches above grade

15. Well grouted? Yes
With: X Neat cement __ Bentonite __ Concrete
Depth: From 0 ft. to 10 ft.

16. Nearest source of possible contamination:
NONE KNOWN
ft. Direction Type
Well disinfected upon completion? __ Yes X No

17. Pump: __ Not installed
Manufacturer's name Berkeley Pump Co.
Model number 1202M-4 HP 80 Volts
Length of drop pipe 60 ft. capacity 900 g.p.m.
Type:
__ Submersible X Turbine
__ Jet __ Reciprocating
__ Centrifugal __ Other

18. Elevation:

Topography:
__ Hill
__ Slope
__ Upland
__ Valley

19. Remarks:

20. Water well contractor's certification:
This well was drilled under my jurisdiction and this report is true to the best of my knowledge and belief.
Clarke Well & Eq., Inc. 185
Business name License No.
Address Great Bend, KS
Signed Authorized representative Date 5-20-76

Forward the white, blue and pink copies to the Department of Health and Environment

Form WWC-5

2S 13W 35 1 CSW
T R Sec 1/4 1/4 1/4