


12 S. 2 E of St. John, Kansas

|   |                                                    |   |                             |                        |
|---|----------------------------------------------------|---|-----------------------------|------------------------|
| 3 | LOCATE WELL'S LOCATION WITH AN "X" IN SECTION BOX. | 4 | DEPTH OF COMPLETED WELL. 80 | ft. ELEVATION: Unknown |
|---|----------------------------------------------------|---|-----------------------------|------------------------|

WELL'S STATIC WATER LEVEL ..... 33 ft. below land surface measured on mo/day/yr 4/21/82

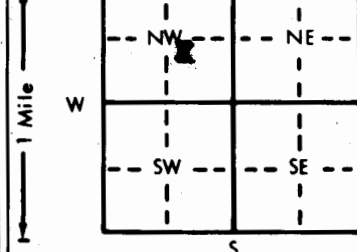

Pump test data: Well water was ..... ft. after ..... hours pumping ..... gpm  
 Est. Yield 60 ..... gpm: Well water was ..... ft. after ..... hours pumping ..... gpm  
 Bore Hole Diameter 8 ..... in. to 80 ..... ft., and ..... in. to ..... ft.

|                           |              |                                 |                          |
|---------------------------|--------------|---------------------------------|--------------------------|
| WELL WATER TO BE USED AS: |              |                                 |                          |
| 1 Domestic                | 3 Feedlot    | 5 Public water supply           | 8 Air conditioning       |
| 2 Irrigation              | 4 Industrial | 6 <u>Oil field water supply</u> | 9 Dewatering             |
|                           |              | 7 Lawn and garden only          | 10 Observation well      |
|                           |              |                                 | 11 Injection well        |
|                           |              |                                 | 12 Other (Specify below) |
|                           |              |                                 | .....                    |

Was a chemical/bacteriological sample submitted to Department? Yes.....No.....; If yes, mo/day/yr sample was submitted

|   |                            |            |                   |                         |                                                         |
|---|----------------------------|------------|-------------------|-------------------------|---------------------------------------------------------|
| 5 | TYPE OF BLANK CASING USED: |            | 5 Wrought iron    | 8 Concrete tile         | CASING JOINTS: <u>Glued</u> . . . . . Clamped . . . . . |
|   | 1 Steel                    | 3 RMP (SR) | 6 Asbestos-Cement | 9 Other (specify below) | Welded . . . . .                                        |
|   | 2 PVC                      | 4 ABS      | 7 Fiberglass      |                         | Threaded . . . . .                                      |

Blank casing diameter . . . . . 5 . . . . . in. to . . . . . 60 . . . . . ft., Dia . . . . . in. to . . . . . ft., Dia . . . . . in. to . . . . . ft.  
Casing height above land surface . . . . . 12 . . . . . in. weight . . . . . 2.8 . . . . . lbs./ft. Wall thickness or gauge No. . . . . Sch. 40

| TYPE OF SCREEN OR PERFORATION MATERIAL: |                    |                 |                              |
|-----------------------------------------|--------------------|-----------------|------------------------------|
| 1 Steel                                 | 3 Stainless steel  | 5 Fiberglass    | 7 <u>PVC</u>                 |
| 2 Brass                                 | 4 Galvanized steel | 6 Concrete tile | 8 RMP (SR)                   |
|                                         |                    |                 | 9 ABS                        |
|                                         |                    |                 | 10 Asbestos-cement           |
|                                         |                    |                 | 11 Other (specify) . . . . . |
|                                         |                    |                 | 12 None used (open hole)     |

|                                     |               |                  |                          |                     |
|-------------------------------------|---------------|------------------|--------------------------|---------------------|
| SCREEN OR PERFORATION OPENINGS ARE: |               | 5 Gauzed wrapped | 8 <u>Saw cut</u>         | 11 None (open hole) |
| 1 Continuous slot                   | 3 Mill slot   | 6 Wire wrapped   | 9 Drilled holes          |                     |
| 2 Louvered shutter                  | 4 Key punched | 7 Torch cut      | 10 Other (specify) ..... |                     |

|                              |         |           |     |      |        |     |
|------------------------------|---------|-----------|-----|------|--------|-----|
| SCREEN-PERFORATED INTERVALS: | From 80 | ft. to 80 | ft. | From | ft. to | ft. |
|                              | From    | ft. to    | ft. | From | ft. to | ft. |
| GRAVEL PACK INTERVALS:       | From 10 | ft. to 80 | ft. | From | ft. to | ft. |
|                              | From    | ft. to    | ft. | From | ft. to | ft. |

6 GROUT MATERIAL: 1 Neat cement 2 Cement grout 3 Bentonite 4 Other .....  
Grout Intervals: From 0 ft. to 10 ft., From ..... ft. to ..... ft., From ..... ft. to ..... ft.

What is the nearest source of possible contamination:

|                          |                      |                 |                        |                                 |
|--------------------------|----------------------|-----------------|------------------------|---------------------------------|
| 1 Septic tank            | 4 Lateral lines      | 7 Pit privy     | 10 Livestock pens      | 14 Abandoned water well         |
| 2 Sewer lines            | 5 Cess pool          | 8 Sewage lagoon | 11 Fuel storage        | 15 <u>Oil well/Gas well</u>     |
| 3 Watertight sewer lines | 6 Seepage pit        | 9 Feedyard      | 12 Fertilizer storage  | 16 <u>Other (specify below)</u> |
| Direction from well?     | <del>XXX</del> South |                 | 13 Insecticide storage | .....                           |
|                          |                      |                 | How many feet?         | 60                              |

[illegible]

7 CONTRACTOR'S OR LANDOWNER'S CERTIFICATION: This water well was (1) constructed, (2) reconstructed, or (3) plugged under my jurisdiction and was completed on (mo/day/year) April 21, 1982 and this record is true to the best of my knowledge and belief. Kansas Water Well Contractor's License No. 186 This Water Well Record was completed on (mo/day/yr) 5/25/82 under the business name of Kellys Water Well Service by (signature) [Signature]

INSTRUCTIONS: Use typewriter or ball point pen, PLEASE PRESS FIRMLY and PRINT clearly. Please fill in blanks, underline or circle the correct answers. Send top three copies to Kansas Department of Health and Environment, Division of Environment, Environmental Geology Section, Topeka, KS 66620. Send one to WATER WELL OWNER and retain one for your records.