

1 LOCATION OF WATER WELL:		Fraction	Section Number		Township Number		Range Number	
County:	Stafford	SE ¼ NW ¼ NE ¼	13		T 25 S		R 14W E/W	


Distance and direction from nearest town or city street address of well if located within city?

6 S, 3 E of Dillwyn, Kansas

2] WATER WELL OWNER:	John Kachelman	Sterling Drilling Co.	Kachelman 1-13
RR#, St. Address, Box # :	Route 1, Box 40	P.O. Box 1006	Board of Agriculture, Division of Water Resources
City, State, ZIP Code :	St. John, Ks. 67576	Pratt, Kansas 67124	Application Number: 950317

3 LOCATE WELL'S LOCATION WITH AN "X" IN SECTION BOX:

4. DEPTH OF COMPLETED WELL..... 83 ft. ELEVATION: Unknown

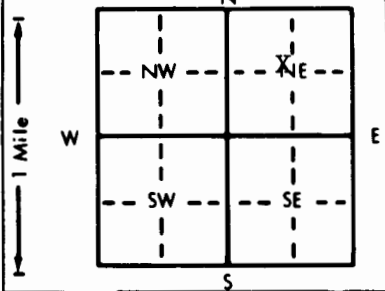

WELL'S STATIC WATER LEVEL 25 ft. below land surface measured on mo/day/yr 10/3/95

Pump test data: Well water was ft. after hours pumping gpm
 Est. Yield 60 gpm: Well water was ft. after hours pumping gpm
 Bore Hole Diameter 7 7/8 in. to 83 ft., and in. to ft.

WELL WATER TO BE USED AS:		5 Public water supply	8 Air conditioning	11 Injection well
1 Domestic	3 Feedlot	<u>6 Oil field water supply</u>	9 Dewatering	12 Other (Specify below)
2 Irrigation	4 Industrial	7 Lawn and garden only	10 Monitoring well	

Was a chemical/bacteriological sample submitted to Department? Yes.....No.....; If yes, mo/day/yr sample was submitted
Water Well Disinfected? Yes.....No.....

5	TYPE OF BLANK CASING USED:		5 Wrought iron	8 Concrete tile	CASING JOINTS: <u>Glued</u> Clamped Welded Threaded
	1 Steel	3 RMP (SR)	6 Asbestos-Cement	9 Other (specify below)	
	2 PVC	4 ABS	7 Fiberglass		

Blank casing diameter 5 in. to 63 ft., Dia in. to ft., Dia in. to ft.
Casing height above land surface 12 in., weight 2.8 lbs./ft. Wall thickness or gauge No. Sch. 40

TYPE OF SCREEN OR PERFORATION MATERIAL:			7 PVC	10 Asbestos-cement
1 Steel	3 Stainless steel	5 Fiberglass	8 RMP (SR)	11 Other (specify)
2 Brass	4 Galvanized steel	6 Concrete tile	9 ABS	12 None used (open hole)

SCREEN OR PERFORATION OPENINGS ARE:		5 Gauzed wrapped	8 <u>Saw cut</u>	11 None (open hole)
1 Continuous slot	3 Mill slot	6 Wire wrapped	9 Drilled holes	
2 Louvered shutter	4 Key punched	7 Torch cut	10 Other (specify)	

SCREEN-PERFORATED INTERVALS:	From 63	ft. to 83	ft. From	ft. to	ft.
	From	ft. to	ft. From	ft. to	ft.
GRAVEL PACK INTERVALS:	From 20	ft. to 83	ft. From	ft. to	ft.
	From	ft. to	ft. From	ft. to	ft.

6 GROUT MATERIAL: 1 Neat cement 2 Cement grout 3 Bentonite 4 Other
Grout Intervals: From 0 ft. to 20 ft., From ft. to ft., From ft. to ft.

What is the nearest source of possible contamination:

1 Septic tank	4 Lateral lines	7 Pit privy	10 Livestock pens	14 Abandoned water well
2 Sewer lines	5 Cess pool	8 Sewage lagoon	11 Fuel storage	15 <u>Oil well/Gas well</u>
3 Watertight sewer lines	6 Seepage pit	9 Feedyard	12 Fertilizer storage	16 Other (specify below)
			13 Insecticide storage	

Direction from well?	South	How many feet?	60
----------------------	-------	----------------	----

[illegible]

7 CONTRACTOR'S OR LANDOWNER'S CERTIFICATION: This water well was (1) constructed, (2) reconstructed, or (3) plugged under my jurisdiction and was completed on (mo/day/year) 10/3/95 and this record is true to the best of my knowledge and belief. Kansas Water Well Contractor's License No. 186 This Water Well Record was completed on (mo/day/yr) 10/4/95 under the business name of Kelly's Water Well Service, Inc. by (signature) Sharon Good