


Kansas Dept. of Health & Environment

TO Division of Environment

(Water well Contractors)

Topeka, KS 66620

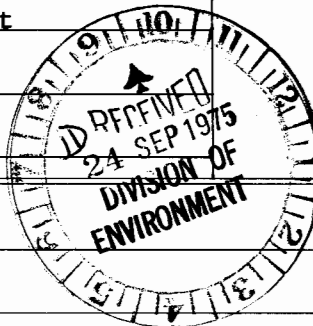

CLARKE WELL & EQUIPMENT, INC.

ROUTE 1 - AIRPORT
GREAT BEND, KANSAS 67530

PHONE: AC316-793-8340

SUBJECT: Well Record Correction

DATE: 9-22-75

FOLD ↑ Gentlemen:

We have made an error in filing a report for an irrigation well we drilled 9-8-75. Owner of this well is Ray Benentendi, Route 2, St. John. Enclosed is a copy of the record we sent you. The error is in the legal description. The legal should be CSE $\frac{1}{4}$ of Section 2-T25S-R14W, Stafford County, KS----NOT CSW $\frac{1}{4}$ 1-T25S-R14W. Sorry for any inconvenience this error has caused you. Thank you.

PLEASE REPLY TO ►

SIGNED: Clarke Well & Equipment, Inc. (License No. 185)

DATE:

SIGNED:



USE TYPEWRITER OR BALL
POINT PEN-PRESS FIRMLY,
PRINT CLEARLY.

WATER WELL RECORD
KSA 82a-1201-1215

Kansas Department of Health and
Environment-Division of Environment
(Water well Contractors)
Topeka, Kansas 66620

1. Location of well:		County Stafford	Fraction C SE 1/4 1/4 CSW 1/4	Section number 2	Township number T 25 S	Range number R 14 E
2. Distance and direction from nearest town or city: 9 1/2 mi. Southwest of St. John, Kansas Street address of well location if in city:			3. Owner of well: Ray Benentendi R.R. or street: Route 2 City, state, zip code: St. John, KS 67576			
4. Locate with "X" in section below: Sketch map:			6. Bore hole dia. 24 in. Completion date 9-8-75 Well depth 120 ft.			
			7. ☐ Cable tool ☐ Rotary ☐ Driven ☐ Dug ☐ Hollow rod ☐ Jetted ☐ Bored ☒ Reverse rotary			
			8. Use: ☐ Domestic ☐ Public supply ☐ Industry ☒ Irrigation ☐ Air conditioning ☐ Stock ☐ Lawn ☐ Oil field water ☐ Other			
			9. Casing: Material Steel Height: Above or below Threaded ☐ Welded ☒ Surface 12 in. RMP ☐ PVC ☐ Weight 30.3 lbs./ft. Dia. 16 in. to 40 ft. depth Wall Thickness: inches or Dia. 16 in. to 95 ft. depth gage No. 7 ga.			
5. Type and color of material			From	To	10. Screen: Manufacturer's name W. A. Brown	
Top soil & brown clay			0	6	Type Double-slot Dia. 16"	
Sand & gravel			6	57	☒ Slot gauge 1/8 Length 45'	
Brown & gray clay clay			57	95	Set between 40 ft. and 60 ft.	
Sand & gravel			95	120	Gravel pack? Yes Size range of material 3/8-200	
					11. Static water level: _____ mo./day/yr. 8 ft. below land surface Date 9-8-75	
					12. Pumping level below land surfaces: N/C _____ ft. after _____ hrs. pumping _____ g.p.m. _____ ft. after _____ hrs. pumping _____ g.p.m. Estimated maximum yield _____ g.p.m.	
					13. Water sample submitted: _____ mo./day/yr. Yes ☐ No ☒ Date _____	
					14. Well head completion: ☐ Pitless adapter 12 inches above grade	
					15. Well grouted? Yes With: ☒ Neat cement ☐ Bentonite ☐ Concrete Depth: From 0 ft. to 10 ft.	
					16. Nearest source of possible contamination: ft. _____ Direction _____ Type _____ Well disinfected upon completion? Yes ☐ No ☒	
					17. Pump: ☒ Not installed Manufacturer's name _____ Model number _____ HP _____ Volts _____ Length of drop pipe _____ ft. capacity _____ g.p.m. Type: ☐ Submersible ☐ Turbine ☐ Jet ☐ Reciprocating ☐ Centrifugal ☐ Other	
			(Use a second sheet if needed)			
18. Elevation:		19. Remarks:		20. Water well contractor's certification: This well was drilled under my jurisdiction and this report is true to the best of my knowledge and belief. Clarke Well & Eq., Inc. 185 Business name _____ License No. _____ Address Great Bend, KS Signed [Signature] Date 9-8-75 Authorized representative		
Topography: ☐ Hill ☐ Slope ☐ Upland ☐ Valley						