

Phone 24

ANDERSEN & DARLING

ENGINEERS KANSAS

Hedotman

—Log Of Test Well—

Stafford

Phone 705

E 05 7th St

Date of Test

9-28-56

Customer

J. T. Kachelman

Address

R. 2, St John

Location


1/8 south of St John

5 miles south of Junction 50-281

4 1/2 west

Static Water Level

NE 13-25-14W

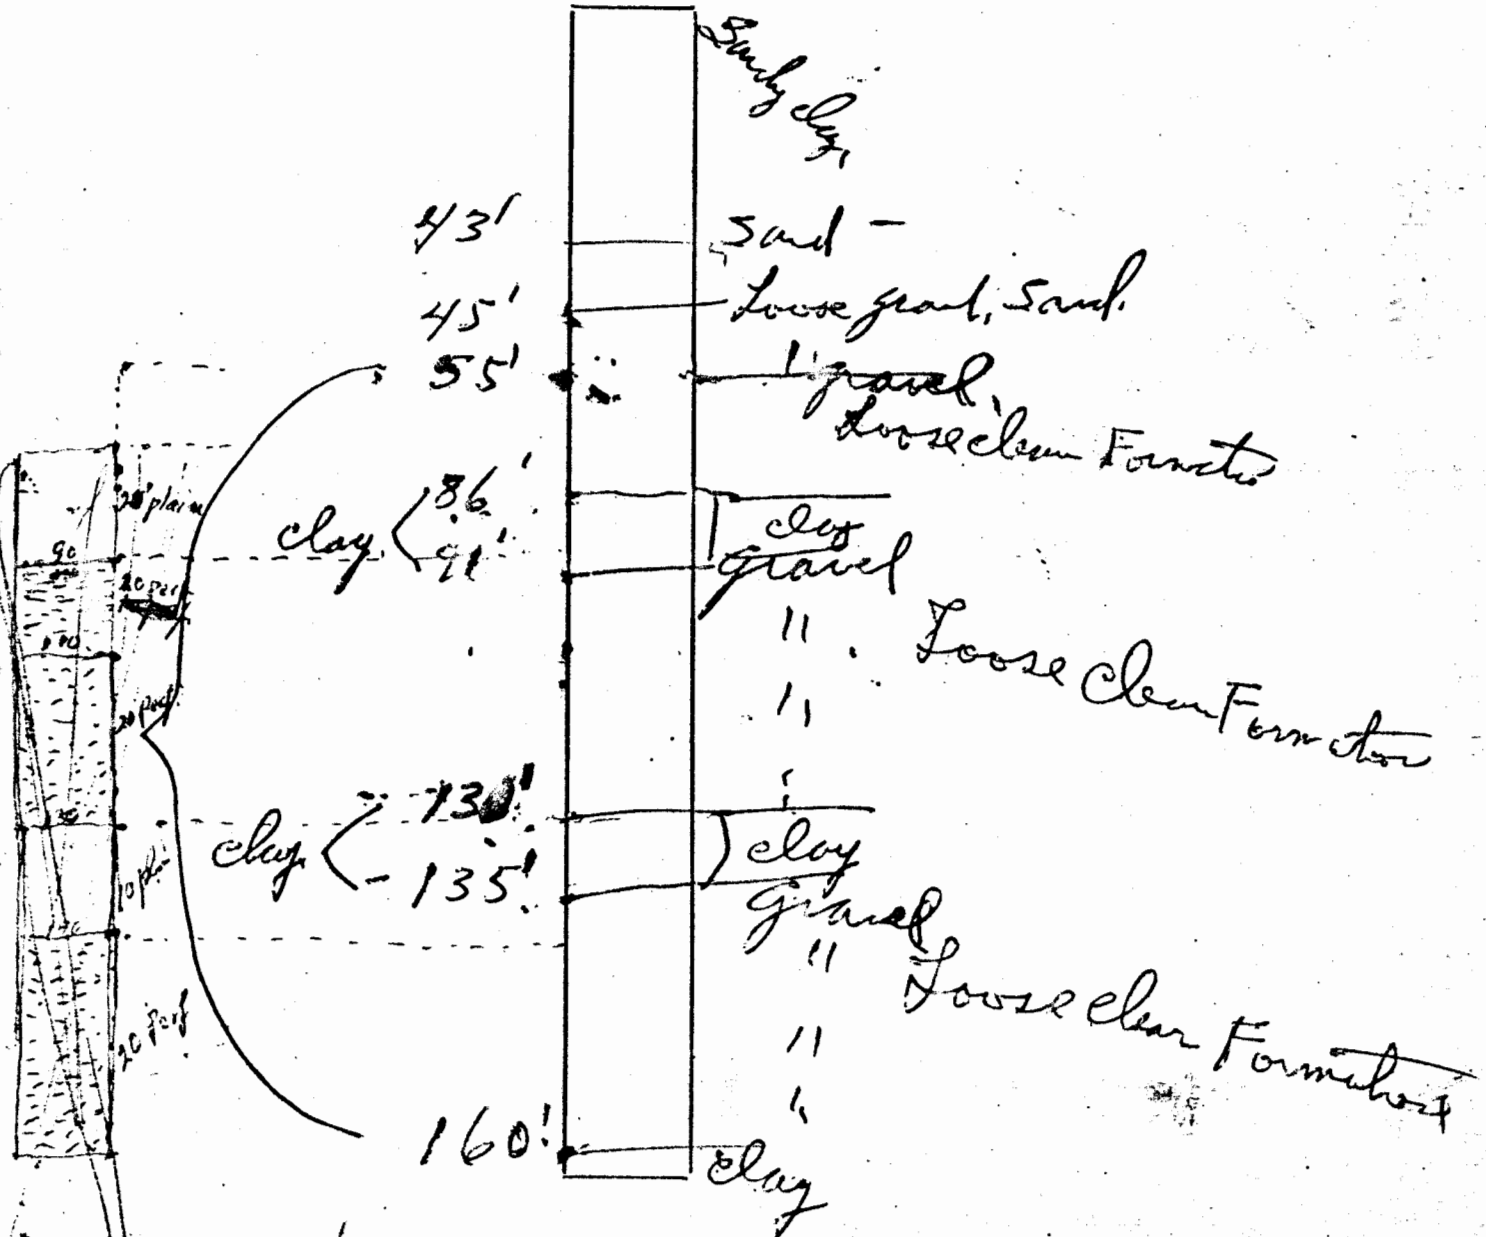

clay

Andersen & Darling
B. J. Fry

WELL DRILLER'S PUMP AND WELL CONTRACT
COMPLETION SHEET

Date 10-10-56

CUSTOMERS NAME John Kaphelman

CUSTOMERS POST OFFICE ADDRESS St. John

LOCATION OF WELL _____

WELL FINISHED 160 FT. DEEP

NUMBER OF FEET OF PLAIN CASING 60 GAUGE 10 DIAMETER 18

NUMBER OF FEET OF PERFORATED CASING 100 GAUGE 10 DIAMETER 18

NUMBER OF FEET OF SCREEN CASING _____ GAUGE _____ DIAMETER _____

SPECIFICATIONS OF PUMP: HEAD NUMBER 8"

LENGTH OF COLUMN PIPE AND SIZE 50' 8" 2 1/2 x 1 1/2

NUMBER OF BOWLS 4 SIZE OF BOWLS 12 CH

ADDITIONAL SUCTION PIPE 1 FT. 10 GAUGE _____ DIA. _____

YARDS OF GRAVEL _____

NUMBER OF ADDITIONAL TESTS RUN 110 HP US. CH 2:3

COSTS OF ADDITIONAL TESTS _____

NAME OF TEST WELL DRILLER _____

ADDITIONAL REMARKS _____

STATIC WATER LEVEL 23 1/2 FT.

ESTIMATED G.P.A. _____ ESTIMATED TOTAL LIFT _____ FEET _____

700	30 ft.
900	- 33
1075	- 36
1200	- 37

NAME OF DRILLER _____

PUMP & WELL PURCHASER (SIGN HERE) _____

NOTE: Please fill in after well is finished and ready for payment. YOU MAY KEEP A COPY FOR YOUR FILES, send or bring promptly to the office.

7/7/53