USE TYPEWRITER OR BALL POINT PEN-PRESS FIRMLY, PRINT CLEARLY.

WATER WELL RECORD
KSA 82a-1201-1215

Kansas Department of Health and Environment-Division of Environment (Water well Contractors) Topeka, Kansas 66620

1. Location of well:	County: Stafford	Fraction: Center of 1/4 1/4 NE 1/4	Section number: 1	Township number: T 25 S	Range number: R 14 E (W)

2. Distance and direction from nearest town or city: 7½ miles Southwest of St. John, KS
Street address of well location if in city:

3. Owner of well: David McCandless
R.R. or street: (?)
City, state, zip code: St. John, KS 67576

4. Locate with "X" in section below:

Sketch map:

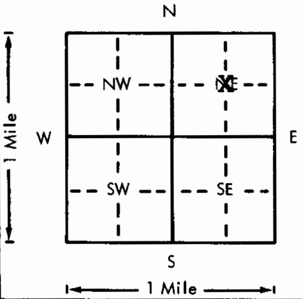

6. Bore hole dia. 24 in. Completion date 5-24-78
Well depth 68 ft. Pump Set 6-27-78

7. __ Cable tool __ Rotary __ Driven __ Dug
__ Hollow rod __ Jetted __ Bored X Reverse rotary

8. Use: __ Domestic __ Public supply __ Industry
X Irrigation __ Air conditioning __ Stock
__ Lawn __ Oil field water __ Other

9. Casing: Material steel Height: (Above) or below Surface 12 in.
Threaded ____ Welded X Weight 30.3 lbs./ft.
RMP ____ PVC ____ Wall Thickness: inches or gage No. 7 ga.
Dia. 16 in. to 28 ft. depth
Dia. ____ in. to ____ ft. depth

5. Type and color of material

Type and color of material	From	To
Top soil	0	2
Gray clay	2	11
Sand & gravel	11	20
Sandstone	20	25
Sandstone and [redacted] gravel	25	30
Yellow clay	30	33
Sand & gravel	33	67
Brown clay	67	68

(Use a second sheet if needed)

10. Screen: Manufacturer's name W. A. Brown
Type Double-slot Dia. 16"
(Slot)/gauze 1/8" Length 40'
Set between 28 ft. and 68 ft.
____ ft. and ____ ft.
Gravel pack? Yes Size range of material 3/8-200

11. Static water level: 12 ft. below land surface Date 5-24-78 mo./day/yr.

12. Pumping level below land surface: Not Checked
____ ft. after ____ hrs. pumping ____ g.p.m.
____ ft. after ____ hrs. pumping ____ g.p.m.
Estimated maximum yield ____ g.p.m.

13. Water sample submitted: __ Yes X No Date ____ mo./day/yr.

14. Well head completion: __ Pitless adapter 12 Inches above grade

15. Well grouted? Yes
With: X Neat cement __ Bentonite __ Concrete
Depth: From 0 ft. to 10 ft.

16. Nearest source of possible contamination: FIELD
ft. ____ Direction ____ Type ____
Well disinfected upon completion? __ Yes X No

17. Pump: __ Not installed
Manufacturer's name Peerless Pump Co.
Model number 12LB-2 HP 80 Volts ---
Length of drop pipe 60 ft. capacity 900 g.p.m.
Type:
__ Submersible X Turbine
__ Jet __ Reciprocating
__ Centrifugal __ Other

18. Elevation:

Topography:
__ Hill
__ Slope
__ Upland
__ Valley

19. Remarks:

20. Water well contractor's certification:
This well was drilled under my jurisdiction and this report is true to the best of my knowledge and belief.
Clarke Well & Eq., Inc. 185
Business name License No.
Address Great Bend, KS 67530
Signed [signature] Date 6-28-78
Authorized representative

Forward the white, blue and pink copies to the Department of Health and Environment

Form WWC-5

T 25 R 14 E (W) Sec 1 1/4 1/4 C NE 1/4