


USE TYPEWRITER OR BALL POINT PEN-PRESS FIRMLY, PRINT CLEARLY.

WATER WELL RECORD
KSA 82a-1201-1215

Kansas Department of Health and Environment-Division of Environment
(Water well Contractors)
Topeka, Kansas 66620

1. Location of well: County STAFFORD Fraction SE 1/4 NW 1/4 SW 1/4 Section number 2 Township number T 25 Range number S R 14 W E/W

2. Distance and direction from nearest town or city: 7E 3 3/4 S
Street address of well location if in city: 1/4 E OF MACKSVILLE
3. Owner of well: GLEN CURTIS
R.R. or street: MACKSVILLE
City, state, zip code: ~~STAFFORD~~, KS

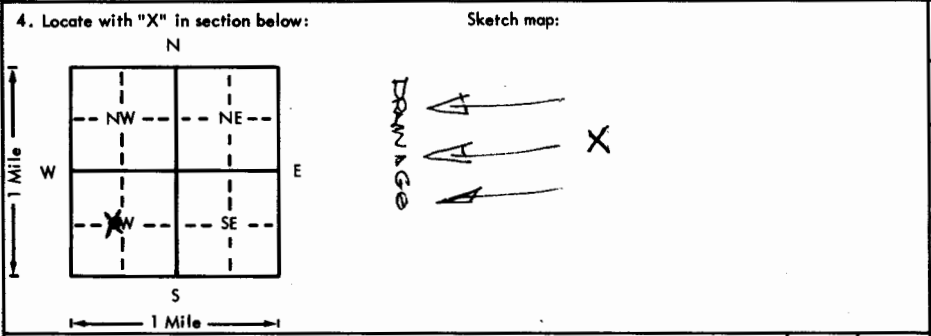

6. Bore hole dia. 28 in. Completion date 9 AUG 76
Well depth 110 ft.
7. Cable tool Rotary Driven Dug
 Hollow rod Jetted Bored Reverse rotary
8. Use: Domestic Public supply Industry
 Irrigation Air conditioning Stock
 Lawn Oil field water Other
9. Casing: Material STL Height: Above or below
Threaded Welded Surface 12 in.
RMP PVC Weight lbs./ft.
Dia. 1 1/2 in. to 70 ft. depth Wall Thickness: inches or
Dia. in. to ft. depth gage No. 188

5. Type and color of material	From	To
SAND, SILTY	0	2
SAND, FINE TO COARSE	2	33
SAND, FINE TO COARSE & MED GRAVEL	33	56
SAND, FINE W/CLAY STREAKS - HARD	56	74
SAND, FINE TO COARSE	74	105
SAND, FINE TO COARSE & MED GRAVEL	105	135
SAND, CEMENTED HARD	135	140
SHALE, BLACK	140	150

10. Screen: Manufacturer's name W.A. BROWN
Type PROLO Dia. 16"
Slot/gauze 48 Length 40'
Set between 70 ft. and 110 ft.
ft. and ft.
Gravel pack? Yes Size range of material 1/2 - 1/8
11. Static water level: mo./day/yr.
3 ft. below land surface Date 9 AUG 76
12. Pumping level below land surfaces:
14 ft. after 1 hrs. pumping 800 g.p.m.
20 ft. after 1 hrs. pumping 1000 g.p.m.
Estimated maximum yield 1800 g.p.m.
13. Water sample submitted: mo./day/yr.
Yes No Date
14. Well head completion:
 Pitless adapter Inches above grade
15. Well grouted? YES
With: Neat cement Bentonite Concrete
Depth: From 0 ft. to 10 ft.
16. Nearest source of possible contamination:
ft. Direction Type NONE
Well disinfected upon completion? Yes No
17. Pump: Not installed
Manufacturer's name FLOWBY
Model number 1220L HP Volts
Length of drop pipe 60 ft. capacity 800 g.p.m.
Type:
 Submersible Turbine
 Jet Reciprocating
 Centrifugal Other

18. Elevation: Hill Slope Upland Valley
19. Remarks: 5'X10' CONCRETE PAD POURED AT SURFACE

20. Water well contractor's certification:
This well was drilled under my jurisdiction and this report is true to the best of my knowledge and belief.
CENTRAL WELL & PUMP 325
Business name License No.
Address 121 S. TAYLOR PLATT, KS
Signed [Signature] Date
Authorized representative

25 T 14 W SE 1/4 SW