


|                           |          |          |        |                |   |                 |       |              |  |
|---------------------------|----------|----------|--------|----------------|---|-----------------|-------|--------------|--|
| 1 LOCATION OF WATER WELL: |          | Fraction |        | Section Number |   | Township Number |       | Range Number |  |
| County:                   | Stafford | NE 1/4   | NW 1/4 | NW 1/4         | 4 | T 25 S          | R 14W | E/W          |  |

Distance and direction from nearest town or city street address of well if located within city?

5 S of Dillwyn, Kansas

|   |                           |                          |                                                   |
|---|---------------------------|--------------------------|---------------------------------------------------|
| 2 | WATER WELL OWNER:         | Allen Drilling Company   |                                                   |
|   | RR#, St. Address, Box # : | 1926 Main                | Board of Agriculture, Division of Water Resources |
|   | City, State, ZIP Code :   | Great Bend, Kansas 67530 | Application Number: Unknown                       |

3 LOCATE WELL'S LOCATION WITH AN "X" IN SECTION BOX: 4 DEPTH OF COMPLETED WELL 62 ft. ELEVATION: Unknown

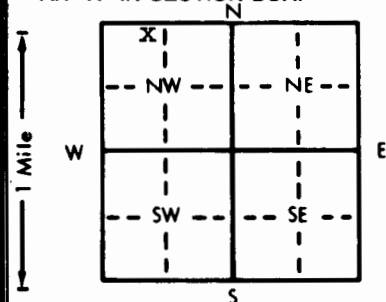

4 DEPTH OF COMPLETED WELL: 62 ft. ELEVATION: Unknown

Depth(s) Groundwater Encountered 1. 19 ft. 2. ft. 3. ft.

WELL'S STATIC WATER LEVEL 19 ft. below land surface measured on mo/day/yr 7/21/81

Pump test data: Well water was ft. after hours pumping gpm

Est. Yield 60 gpm: Well water was ft. after hours pumping gpm

Bore Hole Diameter 8 in. to 62 ft., and in. to ft.

WELL WATER TO BE USED AS:

|              |              |                                 |                     |                          |
|--------------|--------------|---------------------------------|---------------------|--------------------------|
| 1 Domestic   | 3 Feedlot    | 6 <u>Oil field water supply</u> | 9 Dewatering        | 11 Injection well        |
| 2 Irrigation | 4 Industrial | 7 <u>Lawn and garden only</u>   | 10 Observation well | 12 Other (Specify below) |

Was a chemical/bacteriological sample submitted to Department? Yes No; If yes, mo/day/yr sample was submitted

Water Well Disinfected? Yes No

|   |                            |            |                   |                         |                                                                                                   |
|---|----------------------------|------------|-------------------|-------------------------|---------------------------------------------------------------------------------------------------|
| 5 | TYPE OF BLANK CASING USED: |            | 5 Wrought iron    | 8 Concrete tile         | CASING JOINTS: <u>Glued</u> . . . . . Clamped . . . . .<br>Welded . . . . .<br>Threaded . . . . . |
|   | 1 Steel                    | 3 RMP (SR) | 6 Asbestos-Cement | 9 Other (specify below) |                                                                                                   |
|   | 2 PVC                      | 4 ABS      | 7 Fiberglass      |                         |                                                                                                   |
|   |                            |            |                   |                         |                                                                                                   |

Blank casing diameter . . . 5 . . . in. to 42 . . . ft., Dia . . . in. to . . . ft., Dia . . . in. to . . . ft.  
Casing height above land surface . . . 12 . . . in., weight . . . 2.8 . . . lbs./ft. Wall thickness or gauge No. . . Sch. 40

|                                                |                           |                        |                   |                                     |
|------------------------------------------------|---------------------------|------------------------|-------------------|-------------------------------------|
| <b>TYPE OF SCREEN OR PERFORATION MATERIAL:</b> |                           |                        | <b>7 PVC</b>      | <b>10 Asbestos-cement</b>           |
| <b>1 Steel</b>                                 | <b>3 Stainless steel</b>  | <b>5 Fiberglass</b>    | <b>8 RMP (SR)</b> | <b>11 Other (specify) . . . . .</b> |
| <b>2 Brass</b>                                 | <b>4 Galvanized steel</b> | <b>6 Concrete tile</b> | <b>9 ABS</b>      | <b>12 None used (open hole)</b>     |

|                                     |               |                  |                          |                     |
|-------------------------------------|---------------|------------------|--------------------------|---------------------|
| SCREEN OR PERFORATION OPENINGS ARE: |               | 5 Gauzed wrapped | 8 <u>Saw cut</u>         | 11 None (open hole) |
| 1 Continuous slot                   | 3 Mill slot   | 6 Wire wrapped   | 9 Drilled holes          |                     |
| 2 Louvered shutter                  | 4 Key punched | 7 Torch cut      | 10 Other (specify) ..... |                     |

|                              |                                                                                            |
|------------------------------|--------------------------------------------------------------------------------------------|
| SCREEN-PERFORATED INTERVALS: | From . . . . . 42 . . . . . ft. to . 62 . . . . . ft., From . . . . . ft. to . . . . . ft. |
|                              | From . . . . . ft. to . . . . . ft., From . . . . . ft. to . . . . . ft.                   |
| GRAVEL PACK INTERVALS:       | From . . . . . 10 . . . . . ft. to . 62 . . . . . ft., From . . . . . ft. to . . . . . ft. |
|                              | From . . . . . ft. to . . . . . ft., From . . . . . ft. to . . . . . ft.                   |

6 GROUT MATERIAL: 1 Neat cement 2 Cement grout 3 Bentonite 4 Other . . . . .

Grout Intervals: From 0 ft. to 10 ft. From . . . . . ft. to . . . . . ft. From . . . . . ft. to . . . . . ft.

What is the nearest source of possible contamination:

|                                                                    |                 |                 |                        |                             |
|--------------------------------------------------------------------|-----------------|-----------------|------------------------|-----------------------------|
| 1 Septic tank                                                      | 4 Lateral lines | 7 Pit privy     | 10 Livestock pens      | 14 Abandoned water well     |
| 2 Sewer lines                                                      | 5 Cess pool     | 8 Sewage lagoon | 11 Fuel storage        | 15 <u>Oil well/Gas well</u> |
| 3 Watertight sewer lines                                           | 6 Seepage pit   | 9 Feedyard      | 12 Fertilizer storage  | 16 Other (specify below)    |
| Direction from well? <u>100 ft</u> <u>South</u> <u>2</u> <u>ft</u> |                 |                 | 13 Insecticide storage | How many feet? <u>60</u>    |

[illegible]

7 CONTRACTOR'S OR LANDOWNER'S CERTIFICATION: This water well was (1) constructed, (2) reconstructed, or (3) plugged under my jurisdiction and was completed on (mo/day/year) 7/21/81 and this record is true to the best of my knowledge and belief. Kansas

Water Well Contractor's License No. 186 This Water Well Record was completed on (mo/day/yr) 8/25/81  
under the business name of Kellys Water Wells by (signature) George Soad  
INSTRUCTIONS: Use typewriter or ball point pen, PLEASE PRESS FIRMLY and PRINT clearly. Please fill in blanks, underline or circle the correct answers. Send top three copies to Kansas Department of Health and Environment, Division of Environment, Environmental Geology Section, Topeka, KS 66620. Send one to WATER WELL OWNER and retain one for your records.